

**Exhibit A**

Ordinance Permit 20210010301

## **Exhibit H**

### **Form of Public Infrastructure Conveyance**

## **PUBLIC INFRASTRUCTURE CONVEYANCE**

### **ORDINANCE PERMIT # 20210010301**

This Public Infrastructure Conveyance Agreement (“Agreement”) is made and entered into effective January 6, 2022, by and between PROJECT PAUL, LLC, a Delaware limited liability company (“Developer”), and CITY OF SAINT PAUL, MINNESOTA, a municipal corporation existing under the laws of the State of Minnesota (“City”).

NOW, THEREFORE, in consideration of the mutual obligations of the parties hereto, each of them does hereby covenant and agree as follows:

1. Notification. The Developer has delivered to the City a duly executed Certificate of Completion and, thereafter, the City has determined that the applicable components of the Public Infrastructure as described in **Exhibit A** hereto (the “Infrastructure”) appear to have been constructed in accordance with the approved plans and specifications and the preliminary and final plat and has so notified the Developer in writing. As a result, via this Agreement, the Developer is conveying the Property to the City in accordance with the Site Improvement Performance Agreement, dated December 19, 2019. The acceptance of the Infrastructure does not take effect until the Saint Paul City Council accepts the Infrastructure via Resolution.

2. Representations. The Developer hereby represents, certifies, and promises to the City the following:

- (a) With respect to the Property, Developer has complied with the provision of the Redevelopment Agreement, dated December 19, 2019, including that the Property conveyed to the City in this Agreement is completely constructed, constructed in compliance with all applicable Standards as described in the St. Paul Department of Public Works’ Construction of Infrastructure by Private Developers Policy, is free of defects, and is free and clear of any encumbrances or liens.
- (b) A final walk-through inspection with appropriate City staff has been completed and any required corrective work ( written punch list) determined through said walk-through or as determined under the normal and ordinary course of on-site observations by City staff or those hired by the City to complete such observations, has been completed.
- (c) The following documents respecting the Property are complete, accurate, and have been filed with the appropriate department(s) of the City of Saint Paul:
  - (i) Original, reproducible As-Built Plans acceptable to the Department of Public Works, City of Saint Paul are on file with said Department.
  - (ii) Certificate of Completion signed by Engineer of Record who is a licensed Professional Engineer with the State of Minnesota per Minnesota State Statute 326.

[Exhibit N to Site Improvement Performance Agreement (Ford Site)]

- (iii) For sewer systems, video records of televised inspections of sewer mains have been submitted by permittee and approved by Sewer Utility staff.
  - (iv) For sewer systems, sewer connection permit information on file with Public Works.
  - (v) Operation and Maintenance plans.
  - (vi) All other permit requirements as set forth in the Ford site ordinance permit policy.
- (d) Developer has undertaken any and all necessary actions to assign warranties it owns or possesses on or with the Property to the City.
  - (e) Developer will duly execute and deliver any other documents as may be reasonably and customarily required in connection with the transfer of the Property to the City.

3. Conveyance. The Developer hereby dedicates, conveys and assigns in good title to the City of Saint Paul, together with all hereditaments and appurtenances all rights, entitlements, benefits, permits, approvals, and licenses that pertain to, with, or in the Property in its entirety, without reservation or exception, together with all warranties, free and clear of any mortgage, pledge, hypothecation, encumbrance, lease, license, lien or others security interest. If necessary, Developer shall execute a recordable Warranty Deed to be recorded with the Ramsey County Registrar's Office.

IN WITNESS WHEREOF, the City and Developer have caused this Agreement to be duly executed in their names and on their behalf, all on or as of the date first above written.


PROJECT PAUL, LLC,  
a Delaware limited liability company

By: Ryan Companies US, Inc., a Minnesota corporation, its Sole Member

By: Tony Barranco  
Name: Tony Barranco  
Its President

STATE OF Minnesota )  
 ) ss.  
COUNTY OF Hennepin )

The foregoing instrument was acknowledged before me this 16<sup>th</sup> day of January, 2019, by Tony Barranco, the President of Ryan Companies US, Inc., a Minnesota corporation, the Sole Member of Project Paul, LLC, a Delaware limited liability company, on behalf of the limited liability company.

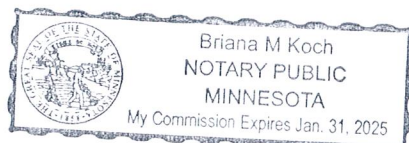

[Signature]  
Notary Public

[Exhibit N to Site Improvement Performance Agreement (Ford Site)]

**Exhibit G**

Form of Completion Certificate



**CITY OF SAINT PAUL DEPARTMENT OF PUBLIC WORKS**

**Certificate of Compliance**

I hereby certify that work completed under this Ordinance Permit and materials provided for installation conform to the appropriate specifications and provisions of and the Department of Public Works, City of Saint Paul, Minnesota, *Standard Supplemental Specifications for Construction of Public Infrastructure by Private Developers Policy*, as amended, and that I am a duly Licensed Professional Engineer under the laws of the State of Minnesota.

Mt Curve Traffic

Project Description

20210010301

Permit Number

53081

10/11/2021

(Signature and License No.)

Date

Kimley-Horn and Associates Inc.

Organization (Print)

1/2012



**CITY OF ST PAUL**  
 Department of Public Works  
 25 West 4th Street  
 1500 City Hall Annex  
 Saint Paul, MN 55102

# ORDINANCE PERMIT

**OFFICE USE ONLY**  
 Application No. \_\_\_\_\_  
 Application Date \_\_\_\_\_  
 SPR File # \_\_\_\_\_  
 Permit No. \_\_\_\_\_

**Type of Permit (select one only):**

- |  |   |   |
|--|---|---|
| <input type="checkbox"/> <del>Base Roadway</del> | <input type="checkbox"/> Roadway Sidewalks          | <input type="checkbox"/> Sanitary Sewer Collection System |
| <input type="checkbox"/> Bridge                  | <input checked="" type="checkbox"/> Roadway Traffic | <input type="checkbox"/> Storm Sewer Collection System    |
| <input type="checkbox"/> Retaining Wall          | <input type="checkbox"/> Sanitary Drop Shaft        | <input type="checkbox"/> Storm Sewer Treatment System     |

**Phase:**

**Location (Street On, From/To, and Adjacent Lots/Blocks):**

**Description of Work:** *[Include the description provided in the permit application and all subsequent amendments or revisions, which are hereby incorporated by reference.]*

<b>Applicant Contact Person:</b>	<b>Contact Person Title:</b>	<b>Contact Person Telephone:</b>	<b>Contact Person Email:</b>
<b>Bond Co.:</b>	<b>Bond Amount:</b>	<b>Bond No.:</b>	
<b>Insurance Co.:</b>	<b>Insurance Certificate No.:</b>		

**Permit Conditions:**

*This permit is issued with the stipulation that the work of the permittee and related agents, employees and contractors shall conform in all respects to the Redevelopment Agreement (including all Legal Requirements as defined by Article 1), the City of Saint Paul Department of Public Works Ordinance Permit Process Document, and the Department of Public Works List of Applicable Standards & Specifications. The permit shall be available for display at the site referred to herein and shown to any Police Officer or Inspector upon demand and does not authorize or allow for interference with the work of any Contract made or to be made with the City of Saint Paul.*

**THIS PERMIT MAY BE REVOKED AT ANY TIME  
 BY THE DIRECTOR OF PUBLIC WORKS**

**A PERMIT FOR THE ABOVE DESCRIBED CONSTRUCTION IS AUTHORIZED BY:**

*David Kuebler* \_\_\_\_\_  
 Signature Title Date

\_\_\_\_\_  
 Printed Name

**PERMIT NUMBER** \_\_\_\_\_

**ITEMS TO BE COMPLETED PRIOR TO ACCEPTANCE OF INFRASTRUCTURE  
AND RELEASE OF PERMIT**

**Prior to acceptance of any infrastructure and release of City permits, the following items must be completed to the satisfaction of the City:**

- Corrective (punch list) work completed;
  
- Original reproducible CAD and PDF as-built plans, signed by the Engineer of Record, provided to Public Works; Submittal of final copies of Metropolitan Council Environmental Services and MN Pollution Control Agency Permits (Sewer Extension, SAC Determination, etc.);
  
- Full compliance with project Quality Management Plan or other document(s) governing quality management and quality assurance;
  
- Documentation of compliance with all applicable City and non-City permit requirements, including, but not limited to: City Public Works Right-of-Way Office, Minnesota Pollution Control Agency, Capitol Region Watershed District, and National Pollution Discharge Elimination System permit requirements;
  
- NA  Documentation of roadway materials at compaction of grading and base, plant mix design report, strength;
  
- NA  Video of all sanitary sewer mains and laterals, storm sewer mains and laterals, and any structural BMP's (pipe galleries, draintile, sediment control structures, weir structures, etc.) installed under any permit, provided to the Public Works Sewer Division;
  
- NA  Sewer Permit drawings for paving connections or stubs installed to service vertical development provided to Public Works, in addition to Private Service Lateral Permit Drawings;
  
- Documentation of Public Works notified for signal and lighting inspection of pole field layouts (staking), conduits and foundations installed, poles and wiring installed, and head positioning and phasing/detection verification (signals only);
  
- NA  For infrastructure within parks: Documentation that Parks Department has been notified of completion status;
  
- NA  All applicable operation and maintenance manuals provided to Public Works; and
  
- Certificate of Compliance signed and submitted to City by Engineer of Record.


**RELEASE OF PERMIT:**

Permit No. \_\_\_\_\_ Council Res. No. \_\_\_\_\_ Permit Date \_\_\_\_\_


Release Authorized by \_\_\_\_\_ Title \_\_\_\_\_

This document, together with the concepts and designs presented herein, as an instrument of service, is intended only for the specific purpose and client for which it was prepared. Reuse of and improper reliance on this document without written authorization and adaptation by Kimley-Horn and Associates, Inc. shall be without liability to Kimley-Horn and Associates, Inc.



**RIGHT OF WAY ORDINANCE PERMIT #5  
EXHIBIT  
04/21/2021**

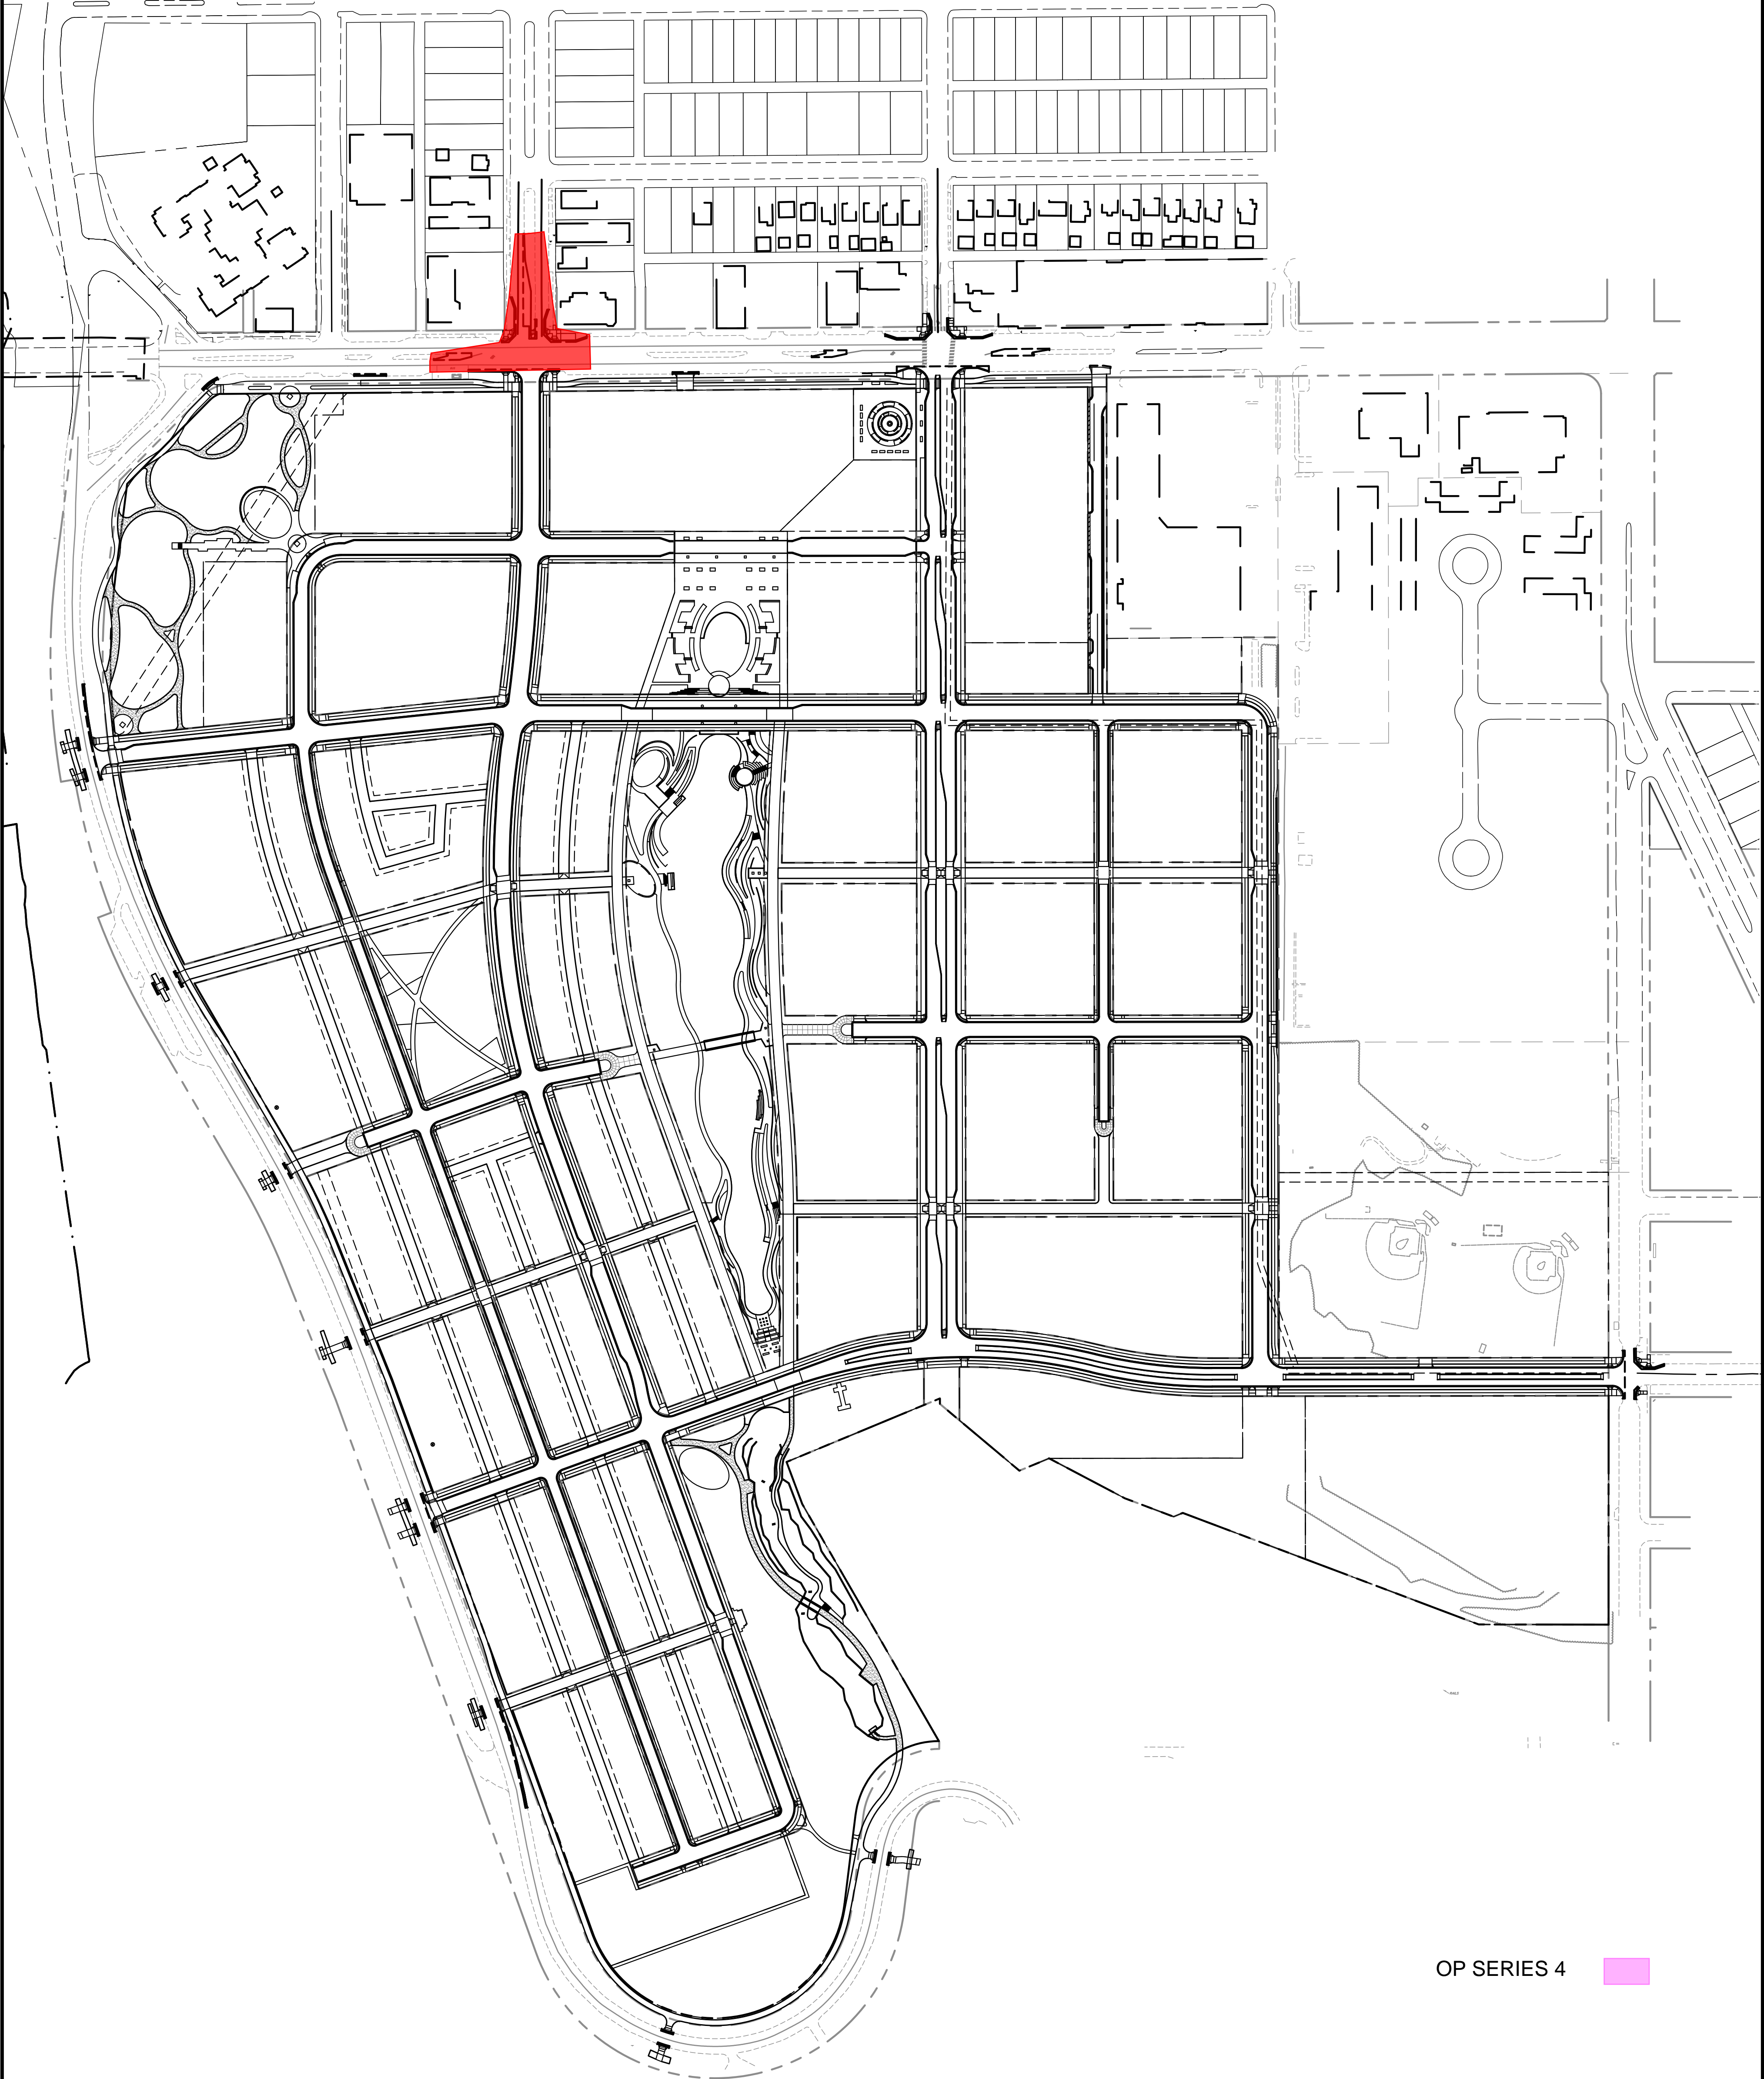


OP SERIES 4

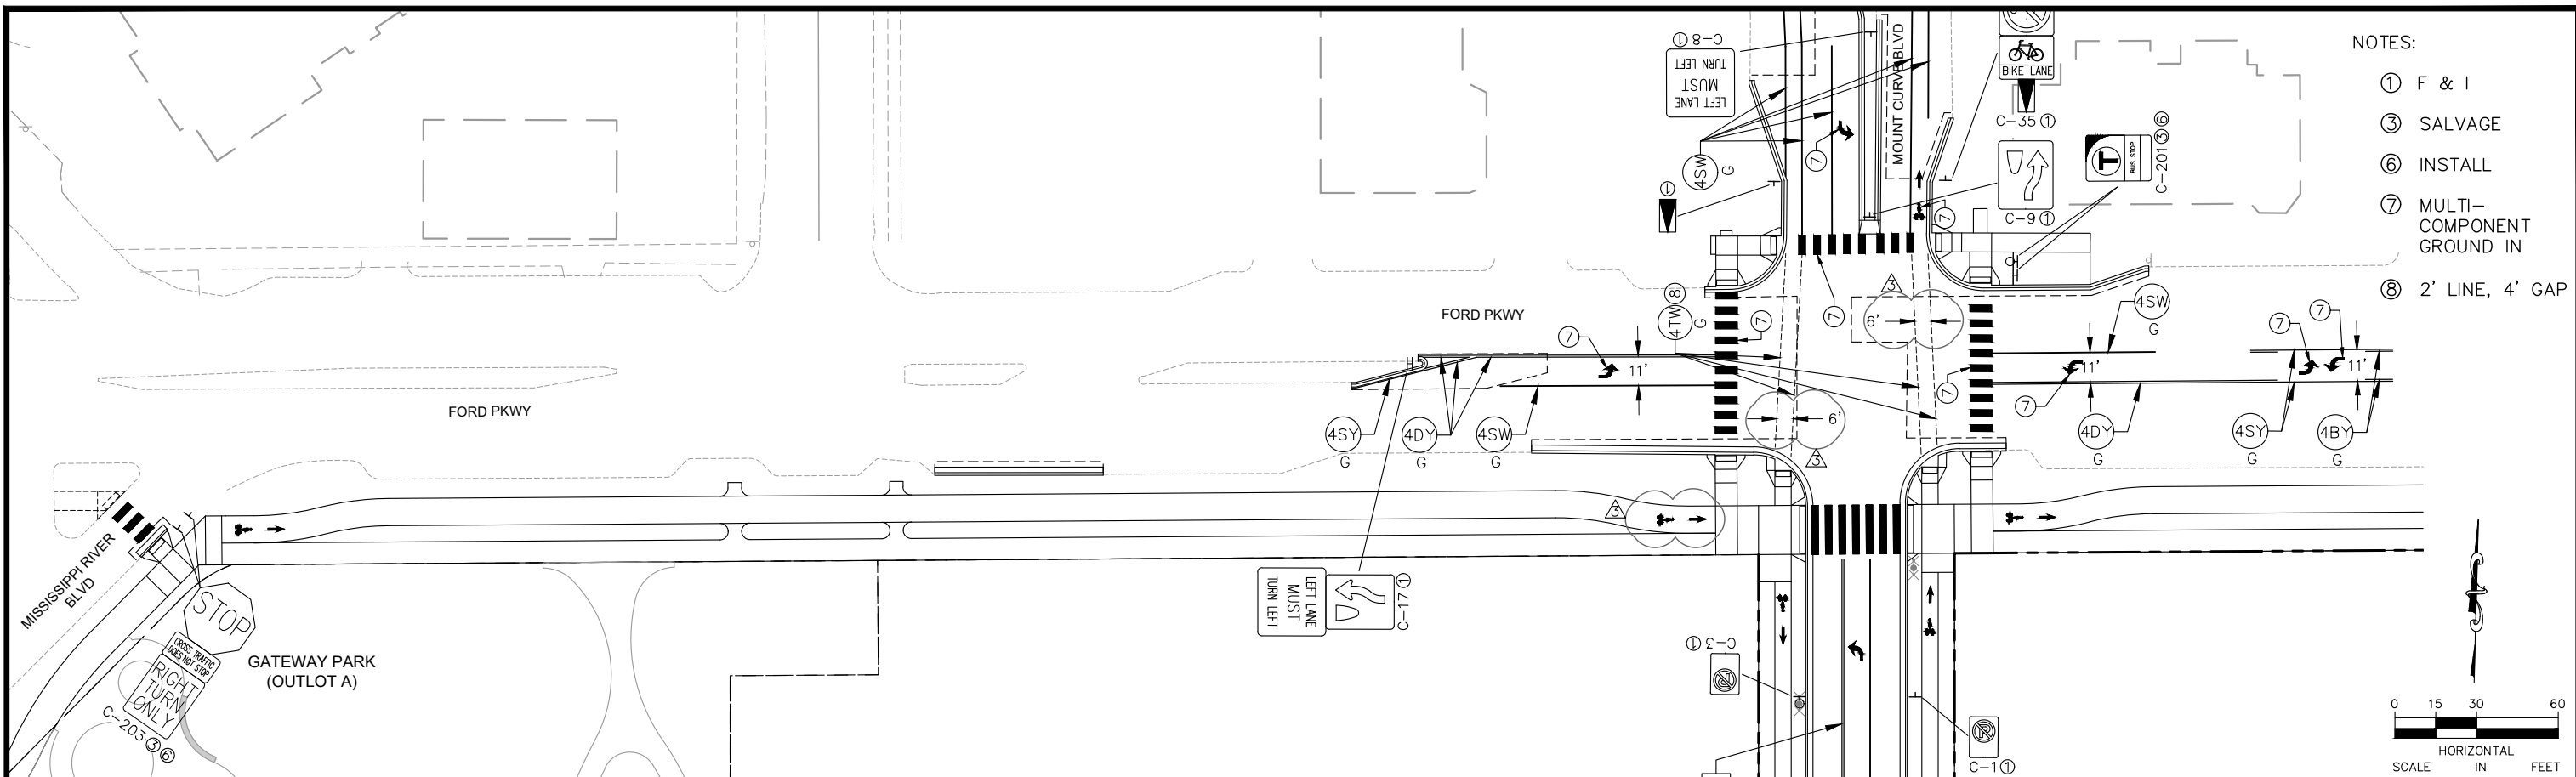

- NOTES:
- ① F & I
  - ③ SALVAGE
  - ⑥ INSTALL
  - ⑦ MULTI-COMPONENT GROUND IN
  - ⑧ 2' LINE, 4' GAP

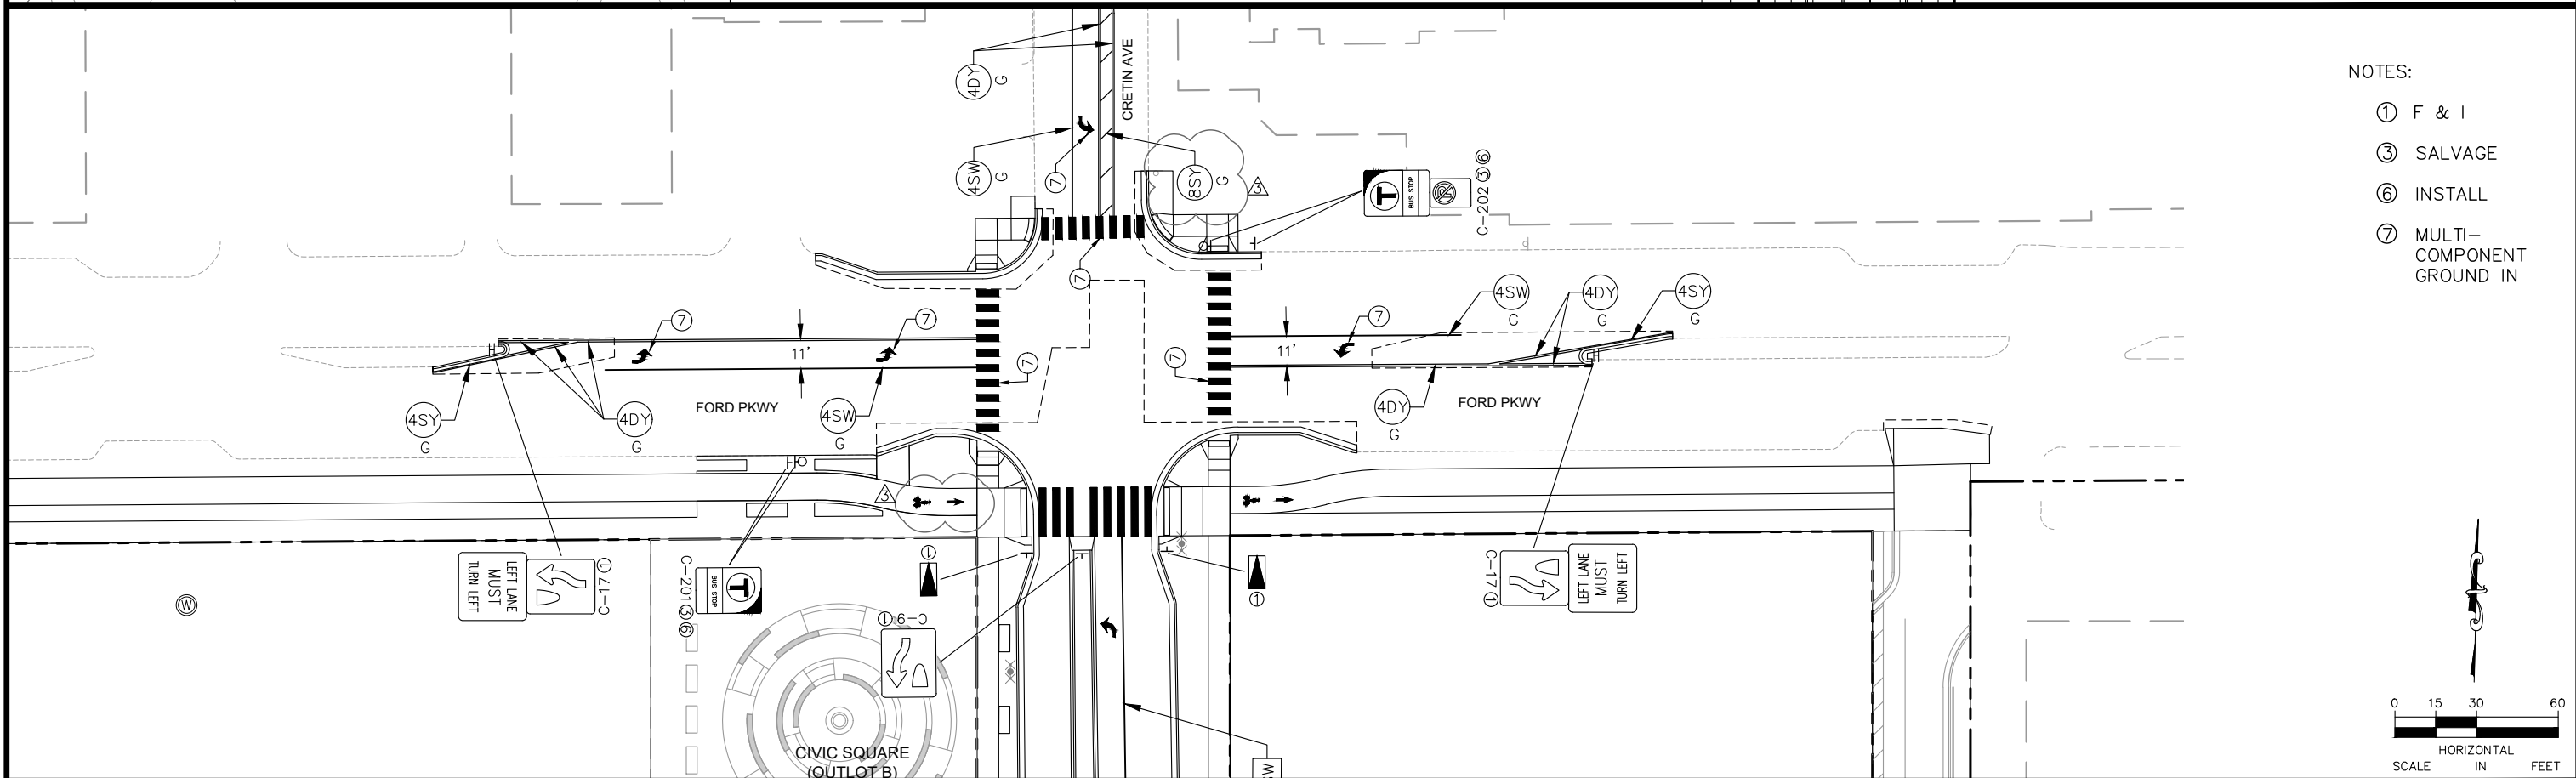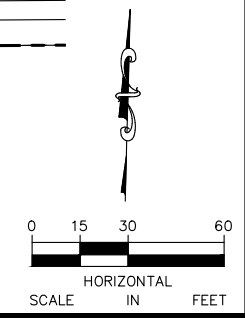

- NOTES:
- ① F & I
  - ③ SALVAGE
  - ⑥ INSTALL
  - ⑦ MULTI-COMPONENT GROUND IN

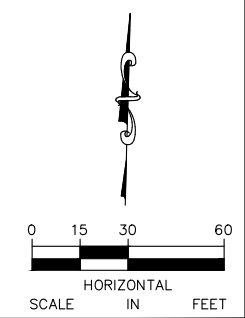


No.	Date	Revisions	App.	DRAWING NAME
2	7/1/20	BULLETIN #2	JAH	Ford SgnStrpPlan EW.dwg
3	8/10/20	BULLETIN #3	JAH	
				DESIGNED BY: CMW
				DRAWN BY: CMW
				CHECKED BY: JAH
				DATE: 05/27/20
				PROJECT NO. 160640016

**Kimley»Horn**  
**ISTHMUS**  
 engineering, inc.

I HEREBY CERTIFY THAT THIS PLAN, SPECIFICATION OR REPORT WAS PREPARED BY ME OR UNDER MY DIRECT SUPERVISION AND THAT I AM A DULY LICENSED PROFESSIONAL ENGINEER UNDER THE LAWS OF THE STATE OF MINNESOTA.

*Joel A. Hinnenkamp*  
 JOEL A. HINNENKAMP, PE  
 DATE: 05/27/20 MN LIC. NO. 53081

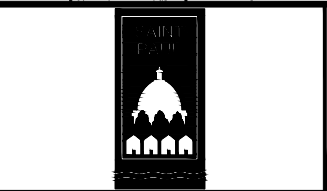

**RYAN COMPANIES US, INC.**  
 FORD SITE REDEVELOPMENT  
 CITY OF ST PAUL, MINNESOTA  
 PRELIMINARY SITE PLAN

FORD PKWY  
 SIGNING AND STRIPING PLANS

SHEET NO.  
**430**

**522**





SIGNAL HEAD CHART				
FACE	R	Y	FYA	G
1-1, 1-2	←	←	←	←
2-1, 2-2, 2-3	●	●	●	●
3-1, 3-2	←	←	←	←
4-1, 4-2	●	●	●	●
5-1, 5-2	←	←	←	←
6-1, 6-2, 6-3	●	●	●	●
7-1, 7-2	←	←	←	←
8-1, 8-2	●	●	●	●

-ALL SIGNAL INDICATIONS SHALL BE 12" LED  
 -ALL SIGNAL HEADS SHALL BE BLACK POLYCARBONATE WITH BACKGROUND SHIELDS  
 -FYA DENOTES FLASHING YELLOW ARROW

HAND HOLE CHART	
NUMBER	SIZE (IN)
1	17"X30"X24"
2	17"X30"X24"
3	13"X24"X12"
4	17"X30"X24"
5	17"X30"X24"
6	13"X24"X12"
7	17"X30"X24"
8	17"X30"X24"
9	13"X24"X12"
10	17"X30"X24"
11	17"X30"X24"
12	17"X30"X24"
13	13"X24"X12"
14	17"X30"X24"

LOOP DETECTOR CHART		
NUMBER	SIZE (FT)	LOCATION
D1-1, D5-1	2-6x6	32 & 48
D1-2, D5-2	2-6x6	0 & 16
D2-1, D2-2	6x6	130
D2-3, D2-4	2-6x6	0 & 16
D6-1, D6-2	6x6	120
D6-3, D6-4	2-6x6	0 & 16
D3-1, D7-1	2-6x6	32 & 48
D3-2, D7-2	2-6x6	0 & 16
D4-1	6x6	120
D8-1	6x6	100
D4-2	SEE DETAIL	1
D4-3, D8-2	2-6x6	0 & 16
D8-3	SEE DETAIL	PED RAMP

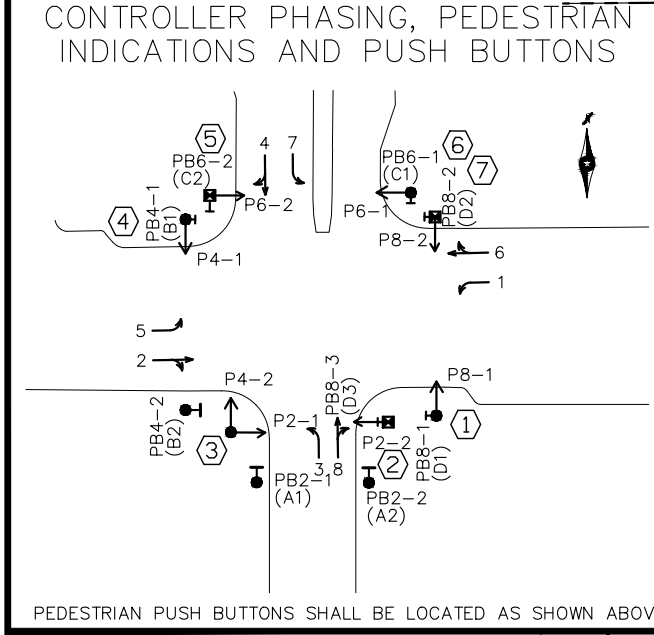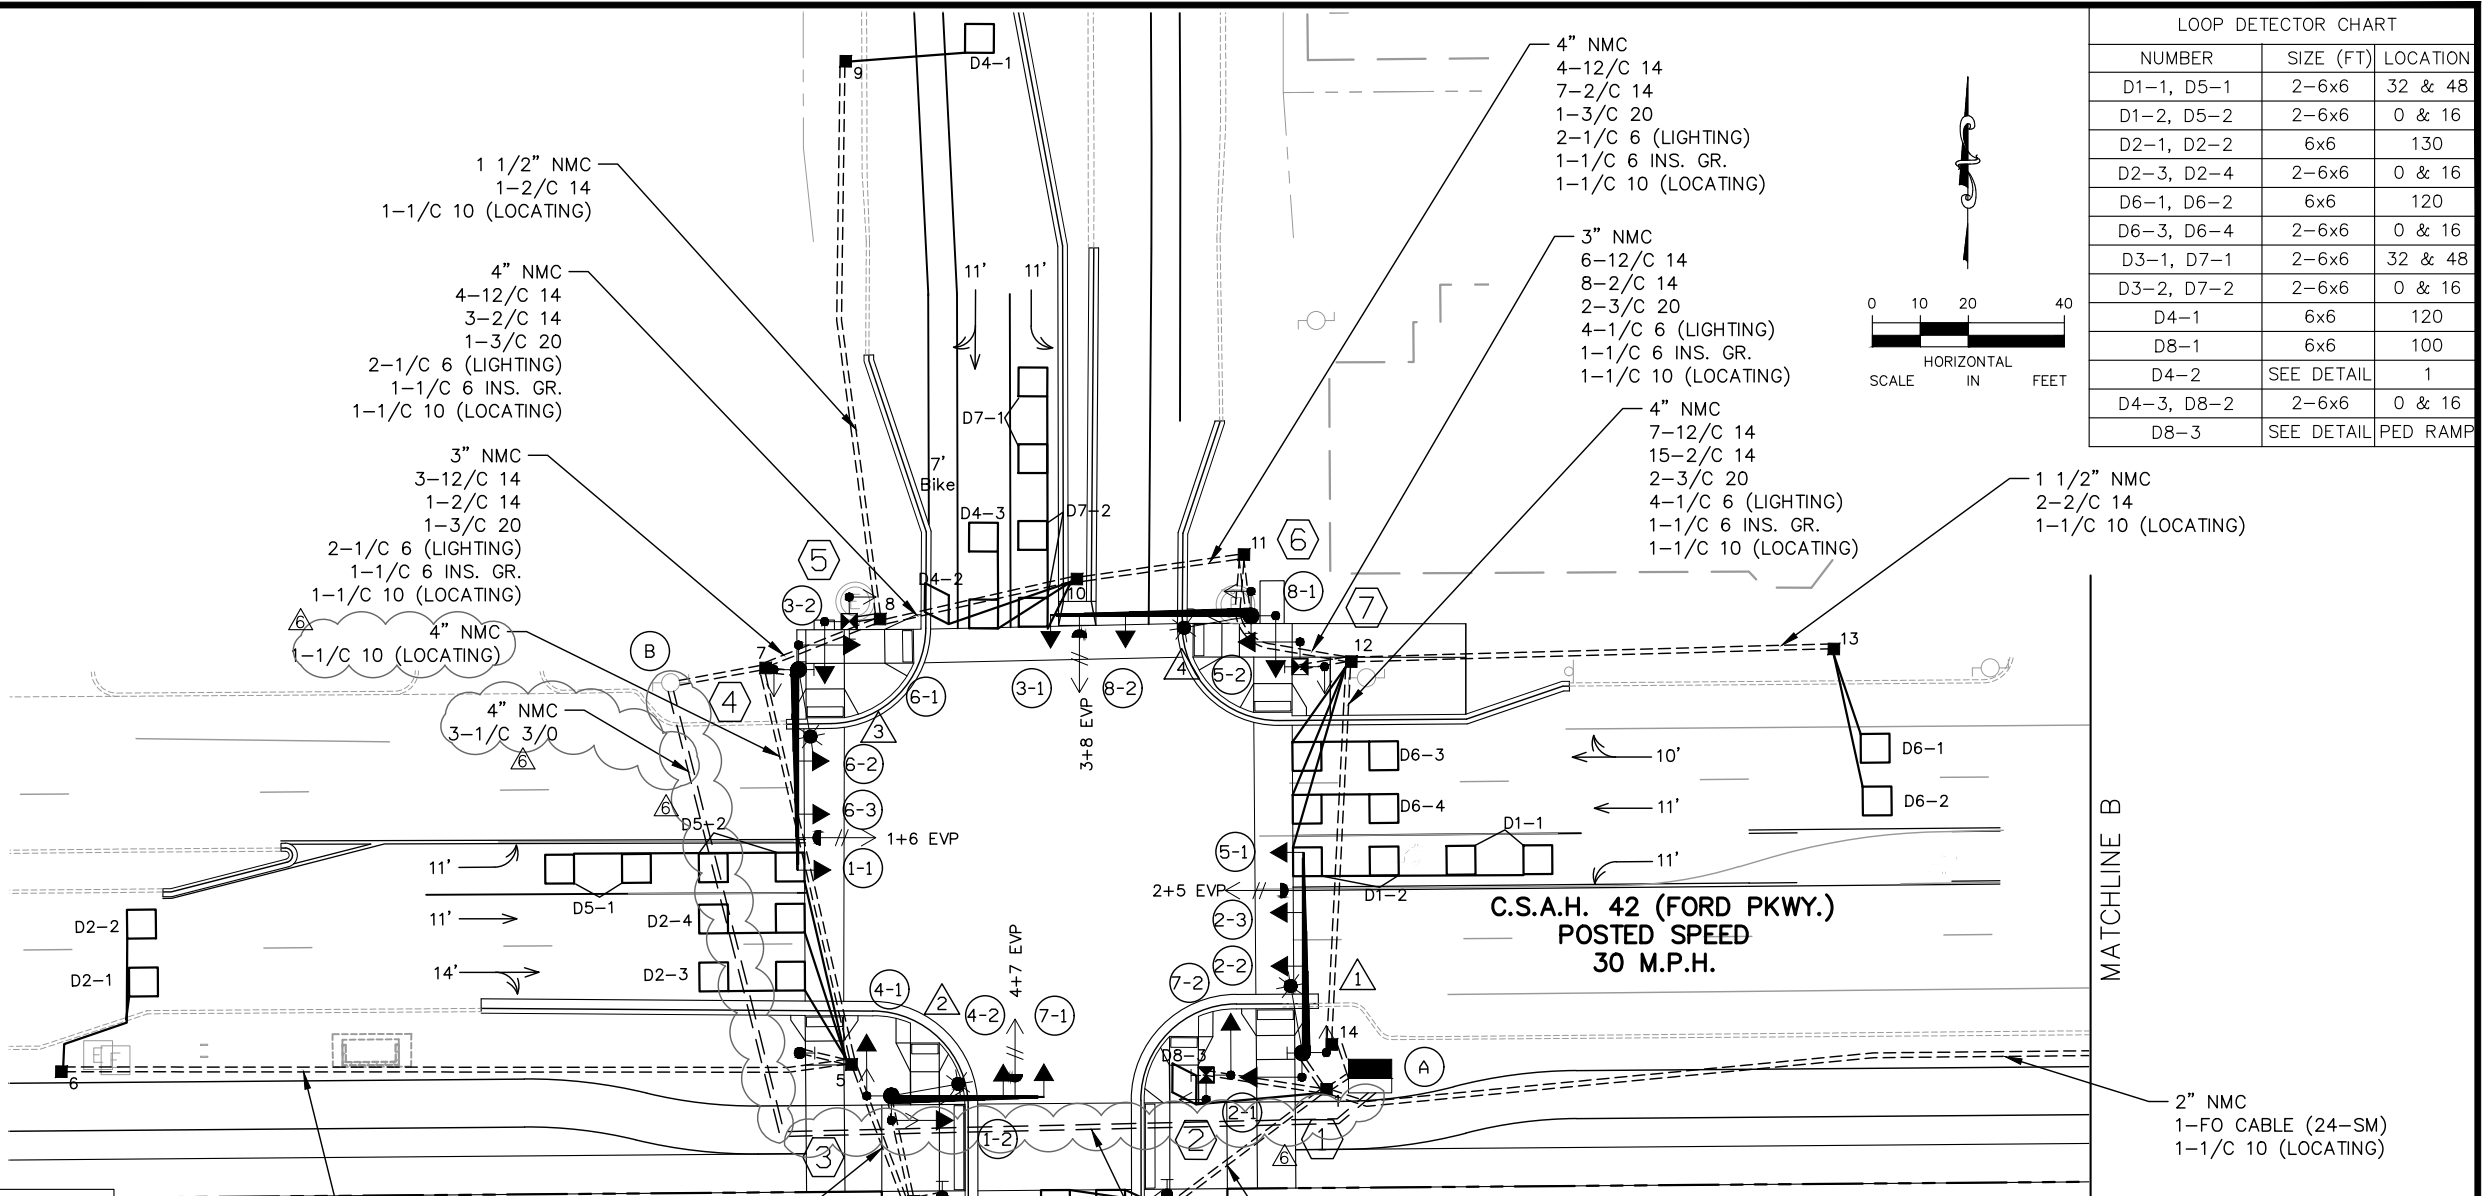

**SIGNAL SYSTEM OPERATION**

- THE SIGNAL SYSTEM FLASH MODE IS ALL RED.
- NORMAL OPERATION IS 8 PHASE, WITH PHASES 1, 3, 5, AND 7 BEING FLASHING YELLOW ARROWS BY TIME OF DAY.
- PHASES 2 AND 6 SHALL BE ON VEHICLE RECALL.

**PED PB STATION 1-APS PB AND SIGN (RT ARROW) (PB4-2)**  
 EXTEND INTO HH 5:  
 1" NMC  
 1-2/C 14  
 1-1/C 6 INS. GR.  
 1-1/C 10 (LOCATING)

**PED PB STATION 1-APS PB AND SIGN (LT ARROW) (PB2-1)**  
 EXTEND INTO HH 4:  
 1" NMC  
 1-2/C 14  
 1-1/C 6 INS. GR.  
 1-1/C 10 (LOCATING)

**PED PB STATION 1-APS PB AND SIGN (RT ARROW) (PB2-2)**  
 EXTEND INTO HH 2:  
 1" NMC  
 1-2/C 14  
 1-1/C 6 INS. GR.  
 1-1/C 10 (LOCATING)


No.	Date	Revisions	App.	DRAWING NAME
2	7/1/20	BULLETIN #2	JAH	ord PlanSignal-MtCurve.dwg
3	8/10/20	BULLETIN #3	JAH	DESIGNED BY: CMW
5	2/19/21	BULLETIN #5	JAH	DRAWN BY: CMW
6	4/2/21	BULLETIN #6	JAH	CHECKED BY: JAH
			JAH	DATE: 4/2/21
			JAH	PROJECT NO. 160640016

**Kimley»Horn**

767 EUSTIS STREET, SUITE 100, ST. PAUL, MN 55114  
 PHONE: 651-645-4197  
 WWW.KIMLEY-HORN.COM

I HEREBY CERTIFY THAT THIS PLAN, SPECIFICATION OR REPORT WAS PREPARED BY ME OR UNDER MY DIRECT SUPERVISION AND THAT I AM A DULY LICENSED PROFESSIONAL ENGINEER UNDER THE LAWS OF THE STATE OF MINNESOTA.

*Joel A. Hinnenkamp*  
 JOEL A. HINNENKAMP, PE  
 DATE: 4/2/21 MN LIC. NO. 53081

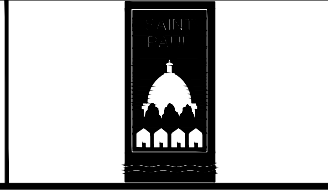


**RYAN COMPANIES US, INC.**  
 FORD SITE REDEVELOPMENT  
 CITY OF ST PAUL, MINNESOTA  
 FINAL SITE PLAN  
 INTERSECTION LAYOUT  
 TRAFFIC CONTROL SIGNAL SYSTEM B  
 C.S.A.H. 42 (FORD PKWY.) & MOUNT CURVE BLVD  
 IN ST. PAUL, RAMSEY COUNTY

SHEET NO.  
**441**  
**522**

MAST ARM MOUNTED SIGNS

SIGN NO	POLE NO	QTY	a	PANEL			MOUNTING STIFFENERS		PANEL LEGEND
				SIZE	AREA	TOTAL AREA	NUMBER	SPACING	
				FEET	INCH	SQ FT	SQ FT	(1)	
R10-X12	1	1	0	36 X 42	10.50	10.50	2	30	LEFT TURN YIELD ON FLASHING YELLOW ARROW
D-3	1	1	25	138 X 24	23.00	23.00	5	30	MOUNT CURVE BLVD
R10-X12	3	1	0	36 X 42	10.50	10.50	2	30	LEFT TURN YIELD ON FLASHING YELLOW ARROW
D-1	3	1	10	84 X 24	14.00	14.00	3	30	FORD PKWY
R10-X12	4	1	0	36 X 42	10.50	10.50	2	30	LEFT TURN YIELD ON FLASHING YELLOW ARROW
D-3	4	1	24	138 X 24	23.00	23.00	5	30	MOUNT CURVE BLVD
R10-X12	6	1	0	36 X 42	10.50	10.50	2	30	LEFT TURN YIELD ON FLASHING YELLOW ARROW
D-1	6	1	22	84 X 24	14.00	14.00	3	30	FORD PKWY

MAST ARM DETAIL

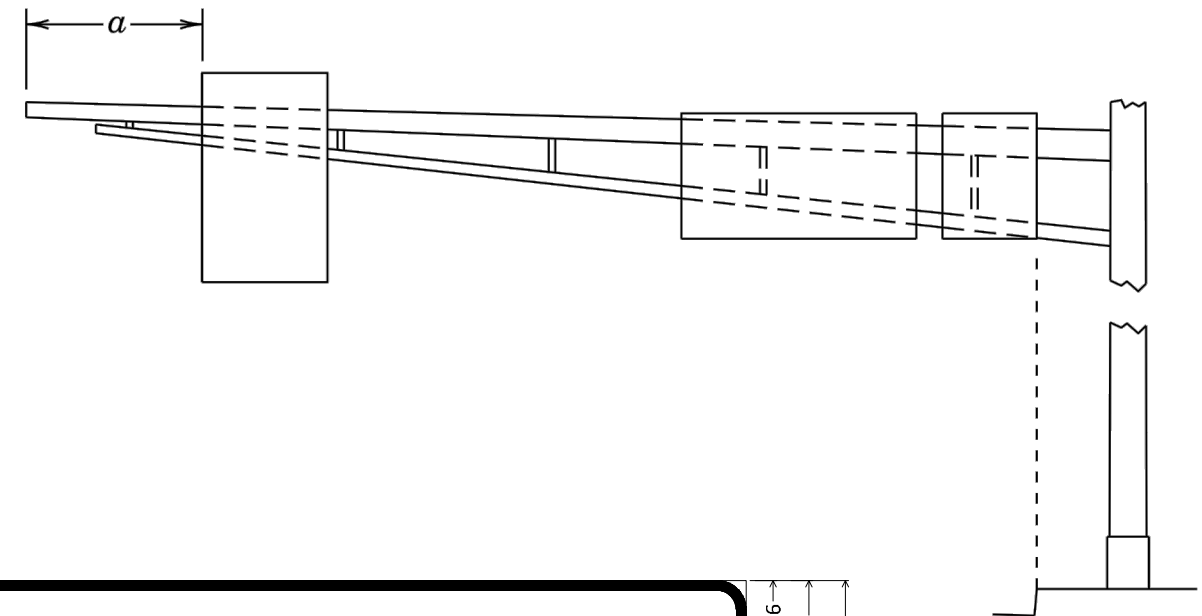


SPECIFIC NOTE:

- (1) SPACING BETWEEN STIFFENERS SHALL NOT EXCEED 36 INCHES AND SHALL BE UNIFORMLY SPACED. SEE MNDOT STANDARD SIGNS AND MARKINGS MANUAL, PAGE 105A FOR STIFFENER SPACING REQUIREMENTS.

GENERAL NOTES:


- CORNERS OF STANDARD SIGN PANELS WITH MARGINS SHALL BE TRIMMED.
- FOR STRUCTURAL DETAILS OF MAST ARM MOUNTED SIGNS SEE MNDOT STANDARD SIGNS AND MARKINGS MANUAL, PAGE 105A.
- FOR TYPE D STRINGER AND PANEL JOINT DETAILS SEE MNDOT STANDARD SIGNS AND MARKINGS MANUAL, PAGE 105.
- THE MAST ARM MOUNTED SIGNS ARE INCLUDED IN THE TRAFFIC CONTROL SIGNAL SYSTEM PAY ITEM.
- FOR MAST ARM SIGN MOUNTING DETAILS, SEE STANDARD PLAN 5-297.731.

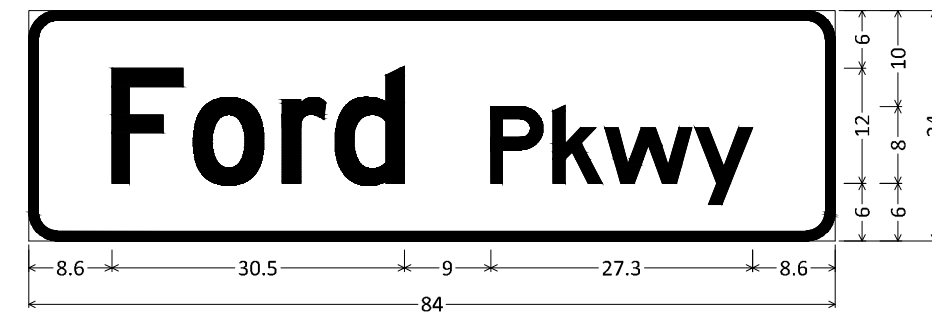

3.0" Radius, 1.0" Border, White on, Green;  
 "Ford", D 2K; "Pkwy", D 2K;  
 Table of letter and object lefts

F	o	r	d	P	k	w	y
8.6	17.1	26.4	31.9	48.1	54.6	60.0	69.4

D-1

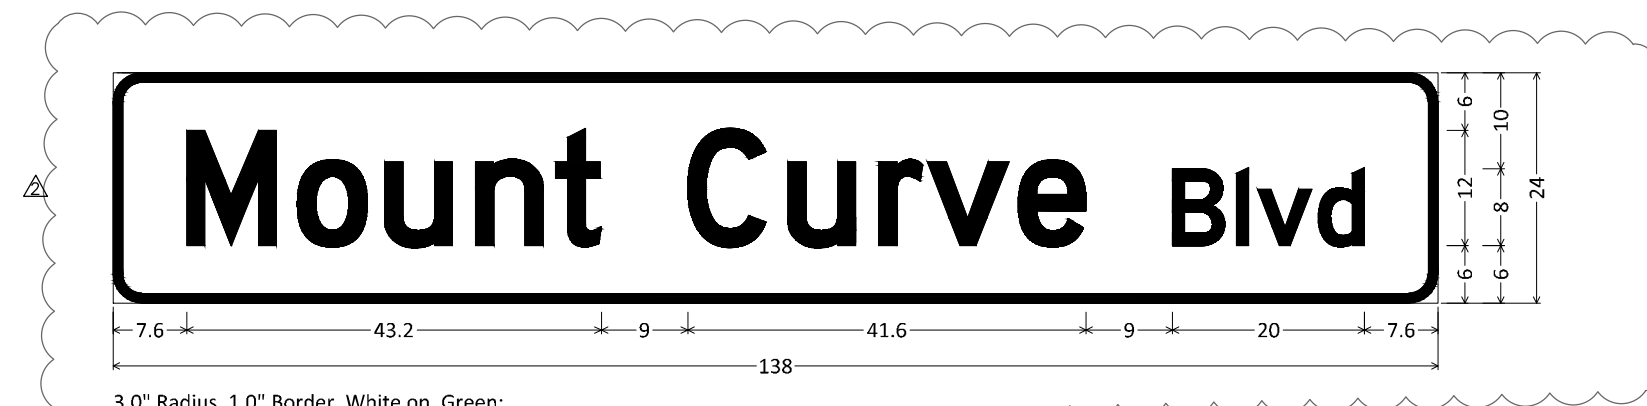

3.0" Radius, 1.0" Border, White on, Green;  
 "Mount Curve", D 2K; "Blvd", D 2K;  
 Table of letter and object lefts

M	o	u	n	t	C	u	r	v	e	B	l	v	d
7.6	19.2	28.3	37.8	46.0	59.8	70.3	79.8	84.8	94.3	110.4	117.0	119.2	125.6

D-3

ALL SIGN DIMENSIONS ARE IN INCHES.

No.	Date	Revisions	App.	DRAWING NAME
2	7/1/20	BULLETIN #2	JAH	Ford PlanSignal-Details.dwg
				DESIGNED BY: CMW
				DRAWN BY: CMW
				CHECKED BY: JAH
				DATE: 05/27/20
				PROJECT NO. 160640016

**Kimley»Horn**  
 767 EUSTIS STREET, SUITE 100, ST. PAUL, MN 55114  
 PHONE: 651-645-4197  
 WWW.KIMLEY-HORN.COM

I HEREBY CERTIFY THAT THIS PLAN, SPECIFICATION OR REPORT WAS PREPARED BY ME OR UNDER MY DIRECT SUPERVISION AND THAT I AM A DULY LICENSED PROFESSIONAL ENGINEER UNDER THE LAWS OF THE STATE OF MINNESOTA.

*Joel A. Hinnenkamp*  
 JOEL A. HINNENKAMP, PE  
 DATE: 05/27/20 MN LIC. NO. 53081

**RYAN**



RYAN COMPANIES US, INC.  
 FORD SITE REDEVELOPMENT  
 CITY OF ST PAUL, MINNESOTA  
 FINAL SITE PLAN  
 MAST ARM SIGN DETAILS  
 TRAFFIC CONTROL SIGNAL SYSTEM B  
 C.S.A.H. 42 (FORD PKWY) & CRETIN AVE  
 IN ST. PAUL, RAMSEY COUNTY

SHEET NO.  
**444**  
**522**