



CITY OF SAINT PAUL
Christopher B. Coleman, Mayor

375 Jackson Street, Suite 220
Saint Paul, Minnesota 55101-1806

Telephone: 651-266-8989
Facsimile: 651-266-9124
Web: www.stpaul.gov/dsi

Application for Sound Level Variance
City of Saint Paul Noise Ordinance
Chapter 293 of the Saint Paul Legislative Code

1. Organization or person seeking variance: MET COUNCIL
2. Mailing Address with Zip Code: CCPD, 540 Fairview Avenue N, Suite 200, St. Paul 55104
3. Responsible person: Anne Taylor
4. Title or position: Project Manager
5. Telephone: 651-602-1449 (desk) 651-276-1305 (cell)
6. Briefly describe the noise source and equipment involved:
Noise sources are ceremonial speeches and music (live + recorded)
Equipment involved will be microphones, amplifiers, speakers
7. Address or legal description of noise source: Union Depot / 214 E. 4th St., St Paul, MN 55101
UNION DEPOT STATION
8. Noise source time of operation: 9AM to 6PM
9. Briefly describe the steps that will be taken to minimize the noise levels:
Amplified sound will not exceed 85 decibels @ 50 ft from the source
10. Briefly state reason for seeking variance: To comply with City policy and to notify the public.
11. Date(s) during which the variance is requested: SATURDAY, JUNE 14, 2014.



Signature of responsible person: _____ Date: _____

Return completed Application and \$164.00 fee to:
CITY OF SAINT PAUL
DEPARTMENT OF SAFETY AND INSPECTIONS
375 JACKSON STREET, SUITE 220
SAINT PAUL, MN 55101-1806
(651) 266-8989

Office Use Only	
Date Rec'd.	_____
Reviewed	_____
Date Public Notice Sent	_____
Referred to Council	_____

NOTE: APPLICATION MUST BE RECEIVED NO FEWER THAN 30 (THIRTY) DAYS PRIOR TO THE EVENT DATE

Feb, 16 2014 05:44 pm I:\900_CAD\SEGMENT-04 (STP)\SHEET\LAND\URD_PLAN\URD-E-PLN-083.dwg By: nicole.gulick

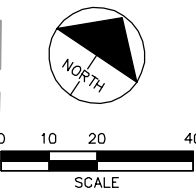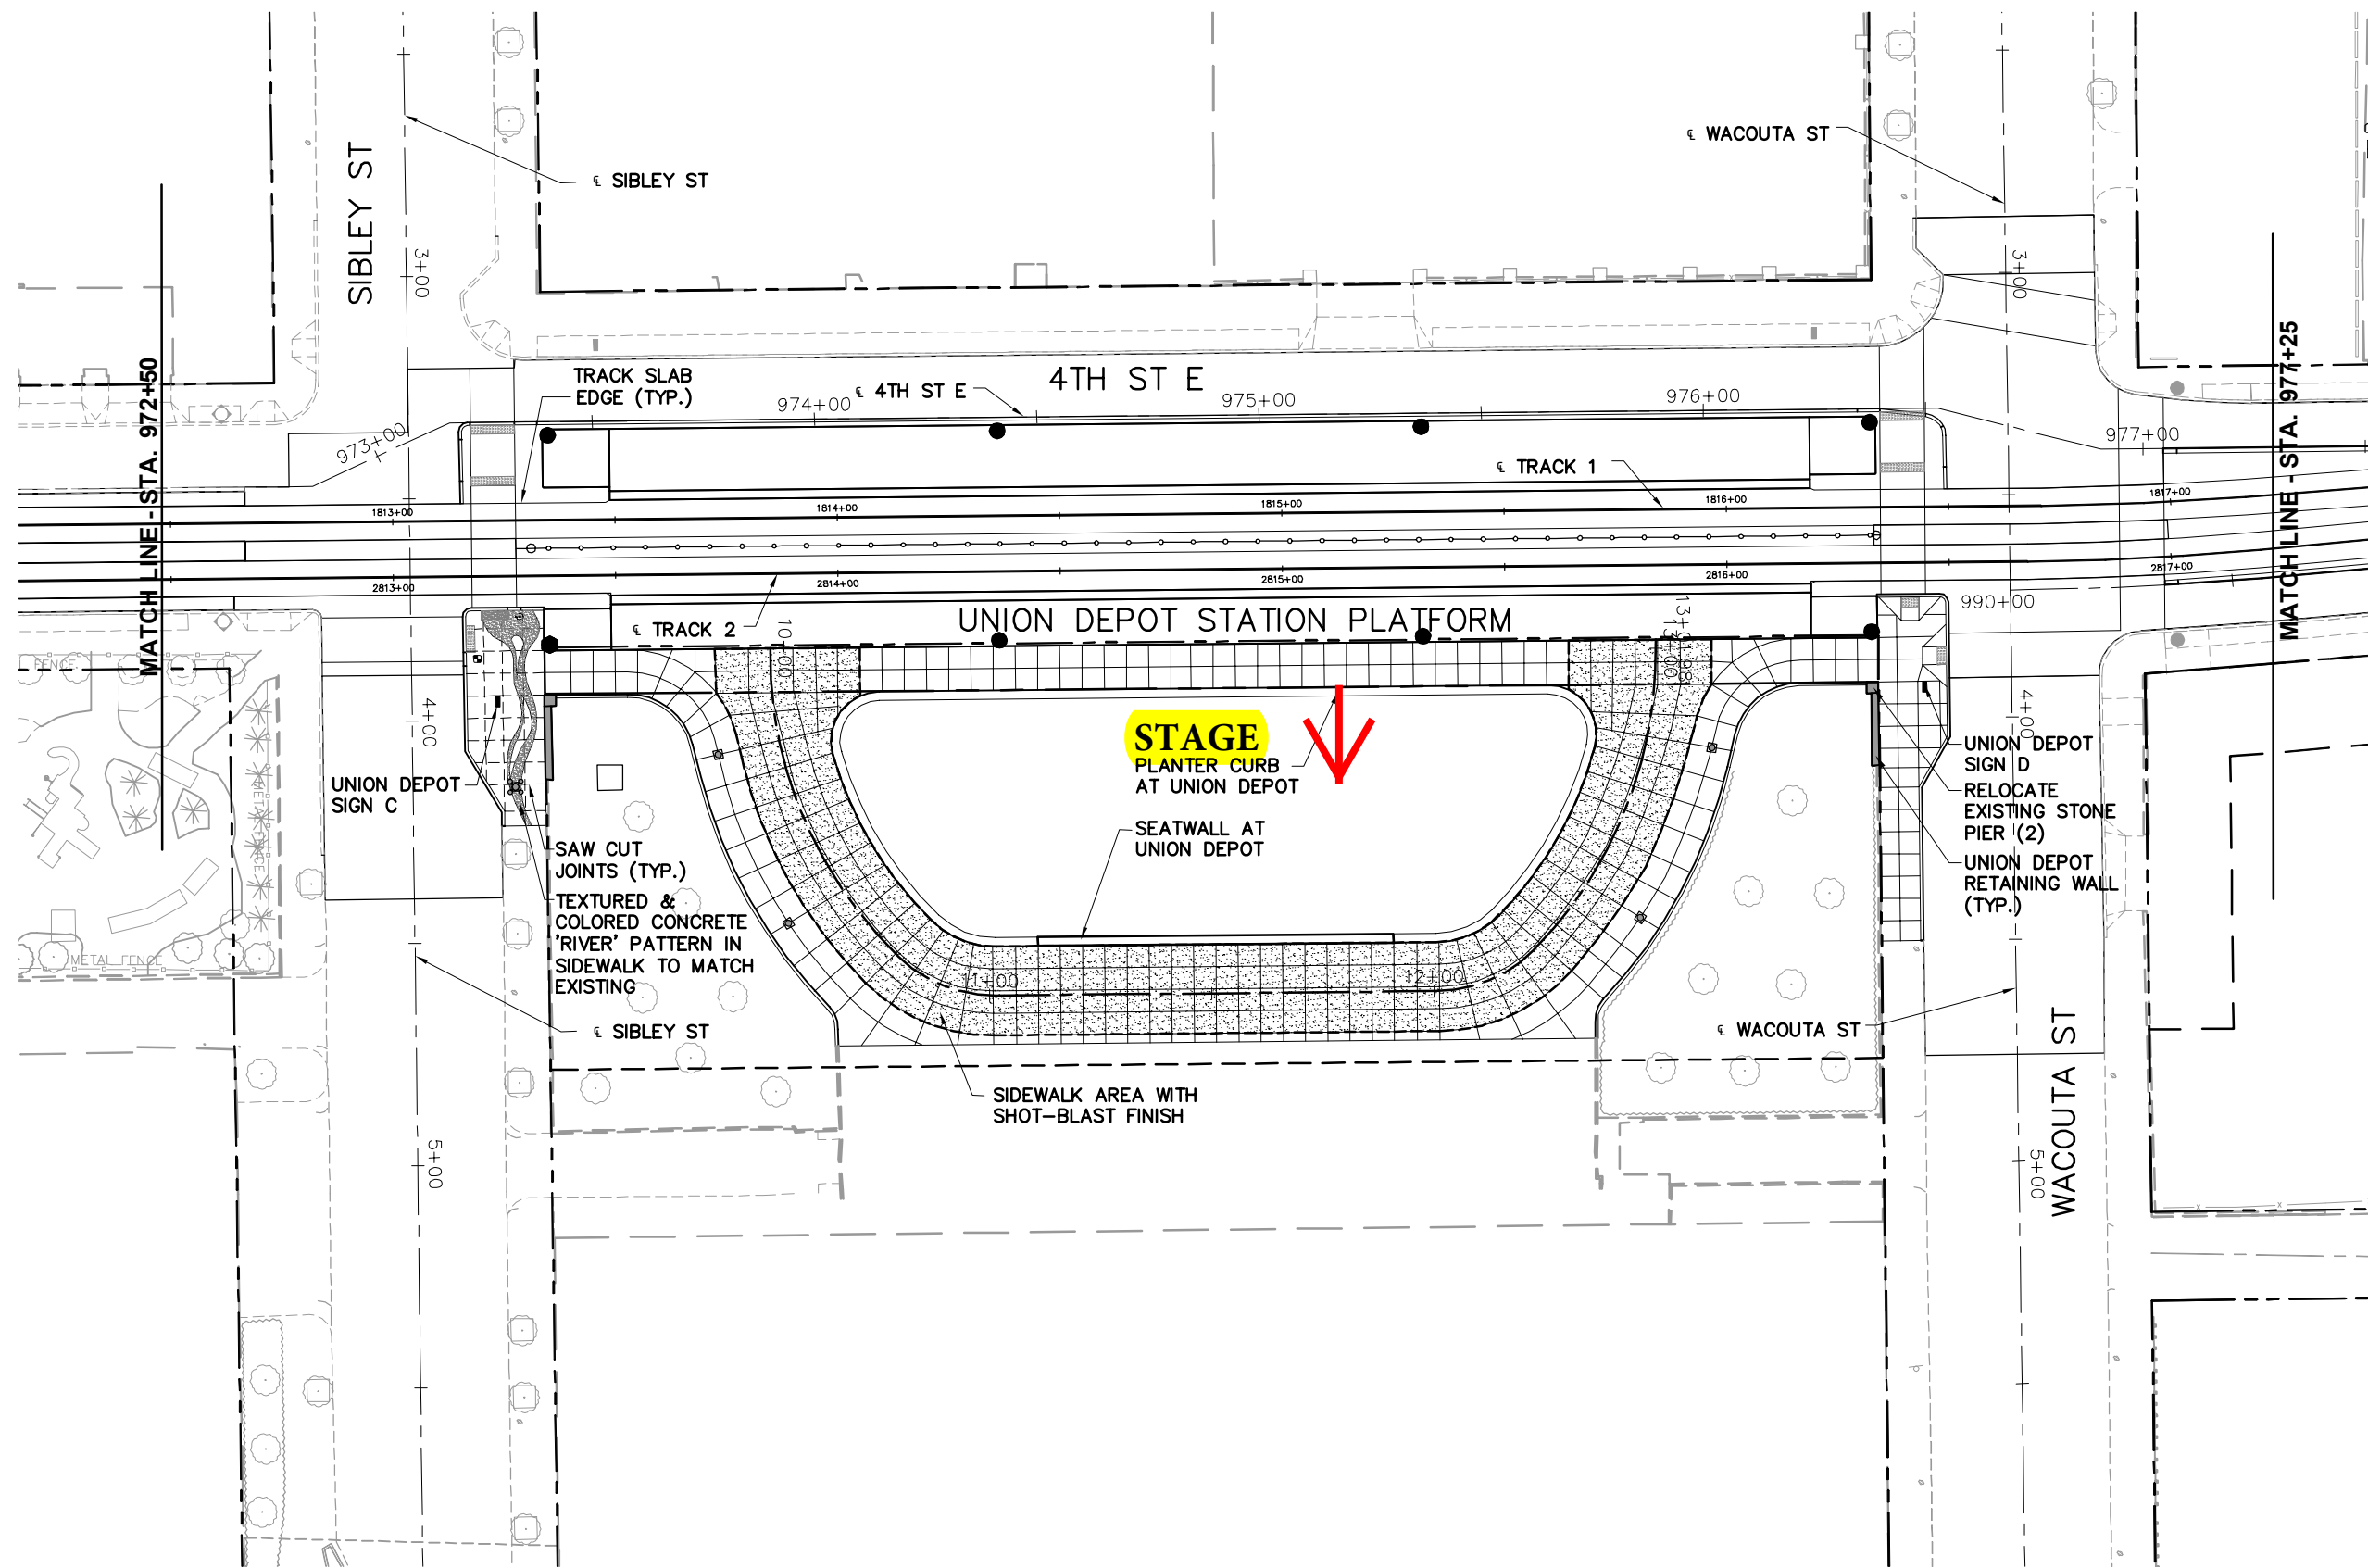

NO.	DATE	BY	CHECK	DESIGN	REVISION / SUBMITTAL
.
.
.
.
A	07/30/2013	RBC	TPH	TPH	AS-BUILT SHEET
3	11/11/2010	ALA	TPH	TRH	PCI-14 - RECIVED TACTILE STRIP PLACEMENT
2	04/23/2010	ALA	TPH	TRH	ADDENDUM NO. 5 - BACKGROUND CHANGES
1	03/31/2010	ALA	TPH	TRH	ADDENDUM NO. 2 - SIDEWALK PATTERN AND JOINTS
0	02/24/2010	ALA	TPH	TRH	ISSUED FOR BID

THESE RECORD DOCUMENTS HAVE BEEN PREPARED BASED ON INFORMATION PROVIDED BY OTHERS TO SHOW THE REPORTED LOCATION OF THE WORK AND SIGNIFICANT CHANGES MADE DURING THE CONSTRUCTION PROCESS. BECAUSE THESE RECORD DOCUMENTS ARE BASED ON UNVERIFIED INFORMATION PROVIDED BY OTHER PARTIES, AECOM AND ITS SUBCONTRACTORS CANNOT AND DO NOT WARRANT THEIR ACCURACY OR COMPLETENESS, AND SHALL NOT BE RESPONSIBLE FOR ANY ERRORS OR OMISSIONS THAT MAY BE INCORPORATED HEREIN AS A RESULT. SIMILARLY, AECOM AND ITS SUBCONTRACTORS ARE NOT RESPONSIBLE FOR THE MEANS OR METHODS OF CONSTRUCTION OR "AS-BUILT" CONSTRUCTION THAT DIFFERS FROM SIGNED AND SEALED DESIGN DRAWINGS. THE PLACING OF ANY PROFESSIONAL SEAL AND THE SIGNATURE OF THE ENGINEER ON THESE RECORD DOCUMENTS ARE SUBJECT TO THE FOREGOING DISCLAIMER OF RESPONSIBILITY AND LIABILITY.

AECOM
 Kimley-Horn and Associates, Inc.

Central Corridor
Light Rail Transit
 Metropolitan Council

CIVIL EAST CONSTRUCTION - VOLUME 7
URBAN DESIGN PLAN
4TH ST E 972+50 - 977+25
 DISCIPLINE: LANDSCAPE ARCH SHEET NAME: URD-E-PLN-083

SHEET
 2719
 OF
 4851