

Exhibit A

Ordinance Permit 20240020402A

**CITY OF ST PAUL**

Department of Public Works
25 West 4th Street
1500 City Hall Annex
Saint Paul, MN 55102

**ORDINANCE
PERMIT****OFFICE USE ONLY**

Application No. _____
Application Date _____
SPR File # _____
Permit No. _____

Type of Permit:

- | | | |
|--|---|--|
| <input type="checkbox"/> 01 Roadway | <input type="checkbox"/> 04 Storm Sewer Collection | <input type="checkbox"/> 07 Sanitary Sewer Special |
| <input type="checkbox"/> 02 Sidewalk | <input type="checkbox"/> 05 Storm Sewer Treatment | <input type="checkbox"/> 08 Retaining Wall |
| <input type="checkbox"/> 03 Traffic Appurtenances Including Signals,
Lighting, EV Infrastructure, Signing, Striping | <input type="checkbox"/> 06 Sanitary Sewer Collection | <input type="checkbox"/> 09 Bridge |

Phase:**Location** (*Street On, From/To, and Adjacent Lots/Blocks*):

at Hawthorne Street. CBs 5250 and 5251: FES5250A

Description of Work: [Include the description provided in the permit application and all subsequent amendments or revisions, which are hereby incorporated by reference.]

Applicant Contact Person:**Contact Person Title:****Contact Person Telephone:****Contact Person Email:****Bond Co.:****Bond Amount:****Bond No.:****Insurance Co.:****Insurance Certificate No.:****Permit Conditions:**

This permit is issued with the stipulation that the work of the permittee and related agents, employees and contractors shall conform in all respects to the City of Saint Paul Department of Public Works Ordinance Permit Process Document and the Department of Public Works List of Applicable Standards & Specifications. The permit shall be available for display at the site referred to herein and shown to any Police Officer or Inspector upon demand and does not authorize or allow for interference with the work of any Contract made or to be made with the City of Saint Paul.

**THIS PERMIT MAY BE REVOKED AT ANY TIME
BY THE DIRECTOR OF PUBLIC WORKS**

A PERMIT FOR THE ABOVE DESCRIBED CONSTRUCTION IS AUTHORIZED BY:

David Kuebler, P. E.

Signature

Title

Date

Printed Name

Permit modified late per
request of developer.

PERMIT NUMBER**A**

ITEMS TO BE COMPLETED PRIOR TO ACCEPTANCE OF INFRASTRUCTURE AND RELEASE OF PERMIT

Prior to acceptance of any infrastructure and release of City permits, the following items must be completed to the satisfaction of the City:

Punch list to be completed as part of roadway ordinance permit,
or other OP if roadway OP not applicable:
DLK 06/19/2025

- ☐ Corrective (punch list) work completed;
 - ☐ Original reproducible CAD and PDF as-built plans, signed by the Engineer of Record, provided to Public Works; Submittal of final copies of Metropolitan Council Environmental Services and MN Pollution Control Agency Permits (Sewer Extension, SAC Determination, etc.);
 - ☐ Full compliance with project Quality Management Plan or other document(s) governing quality management and quality assurance;
 - ☐ Documentation of compliance with all applicable City and non-City requirements including, but not limited to: City Public Works Right-of-Way office, Minnesota Pollution Control Agency, Capitol Region Watershed District, Ramsey-Washington Metro Watershed District.
- NA ☐ Documentation of roadway material test results at compaction of subgrade, grading and base, plant mix design report, insitu strength;
- ☐ Video provided to the City of all sanitary sewer mains and laterals, storm sewer mains and laterals, and any structural BMP's (pipe galleries, draintile, sediment control structures, weir structures, etc.) installed under any permit;
- ☐ Sewer Permit drawings provided to the City for paving connections or stubs installed for the purposes of providing service to private development(s). Sewer Permit drawings are in addition to Private Service Lateral Permit Drawings;
- NA ☐ Documentation that Public Works was notified for signal and lighting inspection of pole field layouts (staking), installed conduits and foundations, installed poles and wiring, signal head positioning, and signal phasing/detection verification;
- NA ☐ For infrastructure within parks: Documentation that the Parks Department has been notified of completion status;
- NA ☐ All applicable operation and maintenance manuals provided to Public Works; and
- ☐ Certificate of Compliance signed by Engineer of Record and provided to the City.

RELEASE OF PERMIT:

Permit No. _____ Council Res. No. _____ Permit Date _____

Release Authorized by _____ Title _____



SAINT PAUL
PUBLIC WORKS

DEPARTMENT OF PUBLIC WORKS
SEAN KERSHAW, DIRECTOR

25 West 4th Street, 1500 City Hall Annex
Saint Paul, MN 55102
Tel: 651-266-6100 | Fax: 651-266-6222

Certificate of Compliance

I hereby certify that work completed under this Ordinance Permit and materials provided for installation conform to the appropriate specifications and provisions of the current State of Minnesota Department of Transportation *Standard Specifications for Construction* and the Department of Public Works, City of Saint Paul, Minnesota, *Standard Supplemental Specifications for Construction*, as amended, and that I am a duly Licensed Professional Engineer under the laws of the State of Minnesota.

The Heights - Infrastructure Construction - Hawthorn and Ivy. MH5250 to FES5250A, scope of work includes catch-basin and lead. - OP 20240020402A

Project Description

License No. 59517

03-20-2025

(Signature and License No.)

Date

Bolton and Menk for Saint Paul Port Authority

Organization (Print)

K:\013987-000\CadPins\SUBMITTAL\013987-000-CF-TITLE-PLAN.dwg 5/7/2024 12:19:47 PM

THE HEIGHTS SITE REDEVELOPMENT

(AKA HILLCREST GOLF COURSE)

ORDINANCE PERMIT APPLICATION 05

ORDINANCE PERMIT 20240020402A

AS-BUILTS

2200 Larpenteur Avenue East, St. Paul, Minnesota

WSB Project Number013987-000

Issue Date01-24-2024; BID PACKAGE NO. 2



© 2021 Microsoft Corporation © 2021 Maxar © CNES (2021) Distribution: Airbus DS



PROJECT LOCATION MAP

SCALE: NOT TO SCALE

THE SUBSURFACE UTILITY INFORMATION SHOWN ON THESE DRAWINGS CONCERNING TYPE AND LOCATION OF PRIVATE UTILITIES HAS BEEN DESIGNATED UTILITY QUALITY LEVEL D. THESE QUALITY LEVELS WERE DETERMINED ACCORDING TO THE GUIDELINES OF C/ASCE 38-02, ENTITLED "STANDARD GUIDELINES FOR THE COLLECTION AND DEPICTION OF EXISTING SUBSURFACE DATA". THE CONTRACTOR IS TO DETERMINE THE TYPE AND LOCATION OF PRIVATE UTILITIES AS MAY BE DEEMED NECESSARY TO AVOID DAMAGE THERETO.

I HEREBY CERTIFIED THAT THIS RECORD DRAWING HAS BEEN PREPARED UNDER MY DIRECT SUPERVISION AND THAT I AM A DULY LICENSED PROFESSIONAL ENGINEER UNDER THE LAWS OF THE STATE OF MINNESOTA. THIS DRAWING HAS BEEN PREPARED IN PART, BASED UPON INFORMATION FURNISHED BY OTHERS. WHILE THIS INFORMATION IS BELIEVED TO BE RELIABLE, BOLTON & MENK, INC. CANNOT ASSURE ITS ACCURACY. THOSE RELYING ON THIS DOCUMENT ARE ADVISED TO OBTAIN INDEPENDENT VERIFICATION OF ITS ACCURACY BEFORE APPLYING IT FOR ANY PURPOSE.

Ashleigh K Rosa

ASHLEIGH K ROSA
LICENSE #: 59517

5-30-2025

DATE

CONTRACTOR:
DESIGNING EARTH CONTRACTING
1282 187th Ln NE
East Bethel, MN 55011

1

2

3

0 - PLAN SHEET IS FOR REFERENCE ONLY
X - PLAN SHEET IS INCLUDED IN BID PACKAGE
BLANK FIELD INDICATES PLAN SHEET NOT INCLUDED

SHEET NO.	DESCRIPTION	BID PACKAGE NO. 2 INFRASTRUCTURE PLANS
1	TITLE SHEET	X
2-3	STATEMENT OF ESTIMATED QUANTITIES	X
4-9	EARTHWORK TABULATIONS	X
10-14	UTILITY TABULATIONS	X
15-23	STANDARD DETAILS	X
24-29	PEDESTRIAN CURB RAMP DETAILS	X
30-31	GENERAL NOTES	X
32-36	EXISTING CONDITIONS PLAN	X
37-45	TYPICAL SECTIONS	X
46-53	ALIGNMENT PLANS	X
54-57	BUILDING DEMOLITION PLAN	
58-62	CONTAMINATED SOILS REMOVAL PLAN	
63-76	SITE PLAN	0
77-95	REMOVAL PLAN	X
96-109	GRADING PLAN	X
110-114	SUBSURFACE STORMWATER STRUCTURE DETAIL	X
115	SUBSURFACE STORMWATER STRUCTURE DETAIL	0
116-120	SPECIAL DRAINAGE STRUCTURE DETAILS	X
121-130	DISTRICT STORMWATER SWALE DETAILS	X
131-134	RETAINING WALL PLAN & DETAILS	0
135-164	SANITARY SEWER AND WATERMAIN CONSTRUCTION	X
165-203	STORM SEWER CONSTRUCTION	X
204-235	STREET CONSTRUCTION	X
236-248	TRAIL CONSTRUCTION PLAN	X
249-260	INTERSECTION DETAILS	X
261-290	PEDESTRIAN RAMP PLAN	X
291-312	STREET LIGHTING PLAN	X
313-323	TRAFFIC CONTROL PLANS	X
324-347	SIGNING AND STRIPING PLANS	X
348	TEMPORARY SEDIMENT CONTROL PLAN & DETAILS	0
349-369	EROSION CONTROL PLAN & DETAILS	X
370-373	STORM WATER POLLUTION PREVENTION PLAN	X
374-435	CROSS SECTIONS	X
436-448	LANDSCAPE AMENITY PLAN (L300-L305, L310-L316)	X
449	TREE PROTECTION DETAILS (L501)	X
450-451	LANDSCAPE AMENITY DETAILS (L601 - L602)	X

THIS PLAN SET CONTAINS 451 SHEETS

DESIGN VEHICLE

LOCAL STREET	DESIGN VEHICLE	ACCOMODATION VEHICLE
WINTHROP ST. N.	P	S-BUS-40
IVY AVE. E.	P	S-BUS-40
CLEAR AVE. E.	P	S-BUS-40
COTTAGE AVE. E.	P	S-BUS-40
SHERWOOD AVE. E.	P	S-BUS-40
ARLINGTON AVE. E.	P	S-BUS-40
NEBRASKA AVE. E.	P	S-BUS-40
HOYT AVE. E.	P	S-BUS-40
IOWA AVE. E.	P	S-BUS-40

MIXED-USE

LIGHT INDUSTRIAL STREET	DESIGN VEHICLE	ACCOMODATION VEHICLE
HOWARD ST. N.	SU-30	WB-40
IDAHO AVE. E.	SU-30	WB-40
MONTANA AVE. E.	WB-40	WB-62
ARLINGTON AVE. E.	WB-40	WB-62

DESIGN DESIGNATION (ARLINGTON, HOWARD, IDAHO, MONTANA)

R VALUE	=	30
PRESENT ADT (2025)	=	0
PROJECTED ADT (2045)	=	3,450
ESALS	=	460,000
DESIGN SPEED	=	25 MPH
BASED ON:		STOPPING SIGHT DISTANCE
HEIGHT OF EYE	=	3.5
HEIGHT OF OBJECT	=	2.0

DESIGN SPEED NOT ACHIEVED AT:

FUNCTIONAL CLASSIFICATION:	LOCAL
NO. OF TRAFFIC LANES:	2
NO. OF PARKING LANES:	1
SHOULDER WIDTH:	2
STRUCTURAL DESIGN STRENGTH:	10 TON

DESIGN DESIGNATION (LOCAL / RESIDENTIAL STREETS)

R VALUE	=	30
PRESENT ADT (2025)	=	0
PROJECTED ADT (2045)	=	1,500
ESALS	=	150,000
DESIGN SPEED	=	25 MPH
BASED ON:		STOPPING SIGHT DISTANCE
HEIGHT OF EYE	=	3.5
HEIGHT OF OBJECT	=	2.0

DESIGN SPEED NOT ACHIEVED AT:

FUNCTIONAL CLASSIFICATION:	LOCAL
NO. OF TRAFFIC LANES:	2
NO. OF PARKING LANES:	1
SHOULDER WIDTH:	2
STRUCTURAL DESIGN STRENGTH:	10 TON

DESIGN DESIGNATION TRAIL

DESIGN SPEED 20 MPH
BASED ON STOPPING SIGHT DISTANCE HEIGHT
OF EYE 4.5 HEIGHT OF OBJECT 0.0

wsb

SCALE: AS SHOWN DESIGN BY:

PLAN BY: PJM CHECK BY: PTH JMT

REVISIONS

NO.	DESCRIPTION	DATE	ADDENDUM NO. 1	ADDENDUM NO. 2	PLAN REVISIONS
1		01/30/2024			
2		02/09/2024			
3		03/29/2024			

I HEREBY CERTIFY THAT THIS PLAN, SPECIFICATION, OR REPORT WAS PREPARED BY ME OR UNDER MY DIRECT SUPERVISION AND THAT I AM A DULY LICENSED PROFESSIONAL ENGINEER UNDER THE LAWS OF THE STATE OF MINNESOTA.

Paul Hornby, P.E.
PAUL HORNBY, P.E.

DATE: 03/29/2024 LIC. NO.: 23359

TITLE SHEET

BID PACKAGE NO. 2
INFRASTRUCTURE PLANS FOR:
SAINT PAUL, MINNESOTA

Saint Paul
Port Authority
400 Wabasha Street North
Suite 240
St Paul, Minnesota 55102
Phone 612-224-5686

WSB PROJECT NO.
013987-000

REVISIONS	
NO.	DESCRIPTION

I HEREBY CERTIFY THAT THIS PLAN, SPECIFICATION, OR REPORT WAS PREPARED BY ME OR UNDER MY DIRECT SUPERVISION AND THAT I AM A DULY LICENSED PROFESSIONAL ENGINEER UNDER THE LAWS OF THE STATE OF MINNESOTA.



PAUL HORNBY, P.E.
DATE: 03/29/2024 LIC. NO: 23359

OVERALL
STORM SEWER
CONSTRUCTION








INFRASTRUCTURE PLANS FOR:
THE HEIGHTS
SAINT PAUL, MINNESOTA

Saint Paul
Port Authority
400 Wabasha Street North
Suite 240
St Paul, Minnesota 55102
Phone 612-224-5686

WSB PROJECT NO.
013987-000

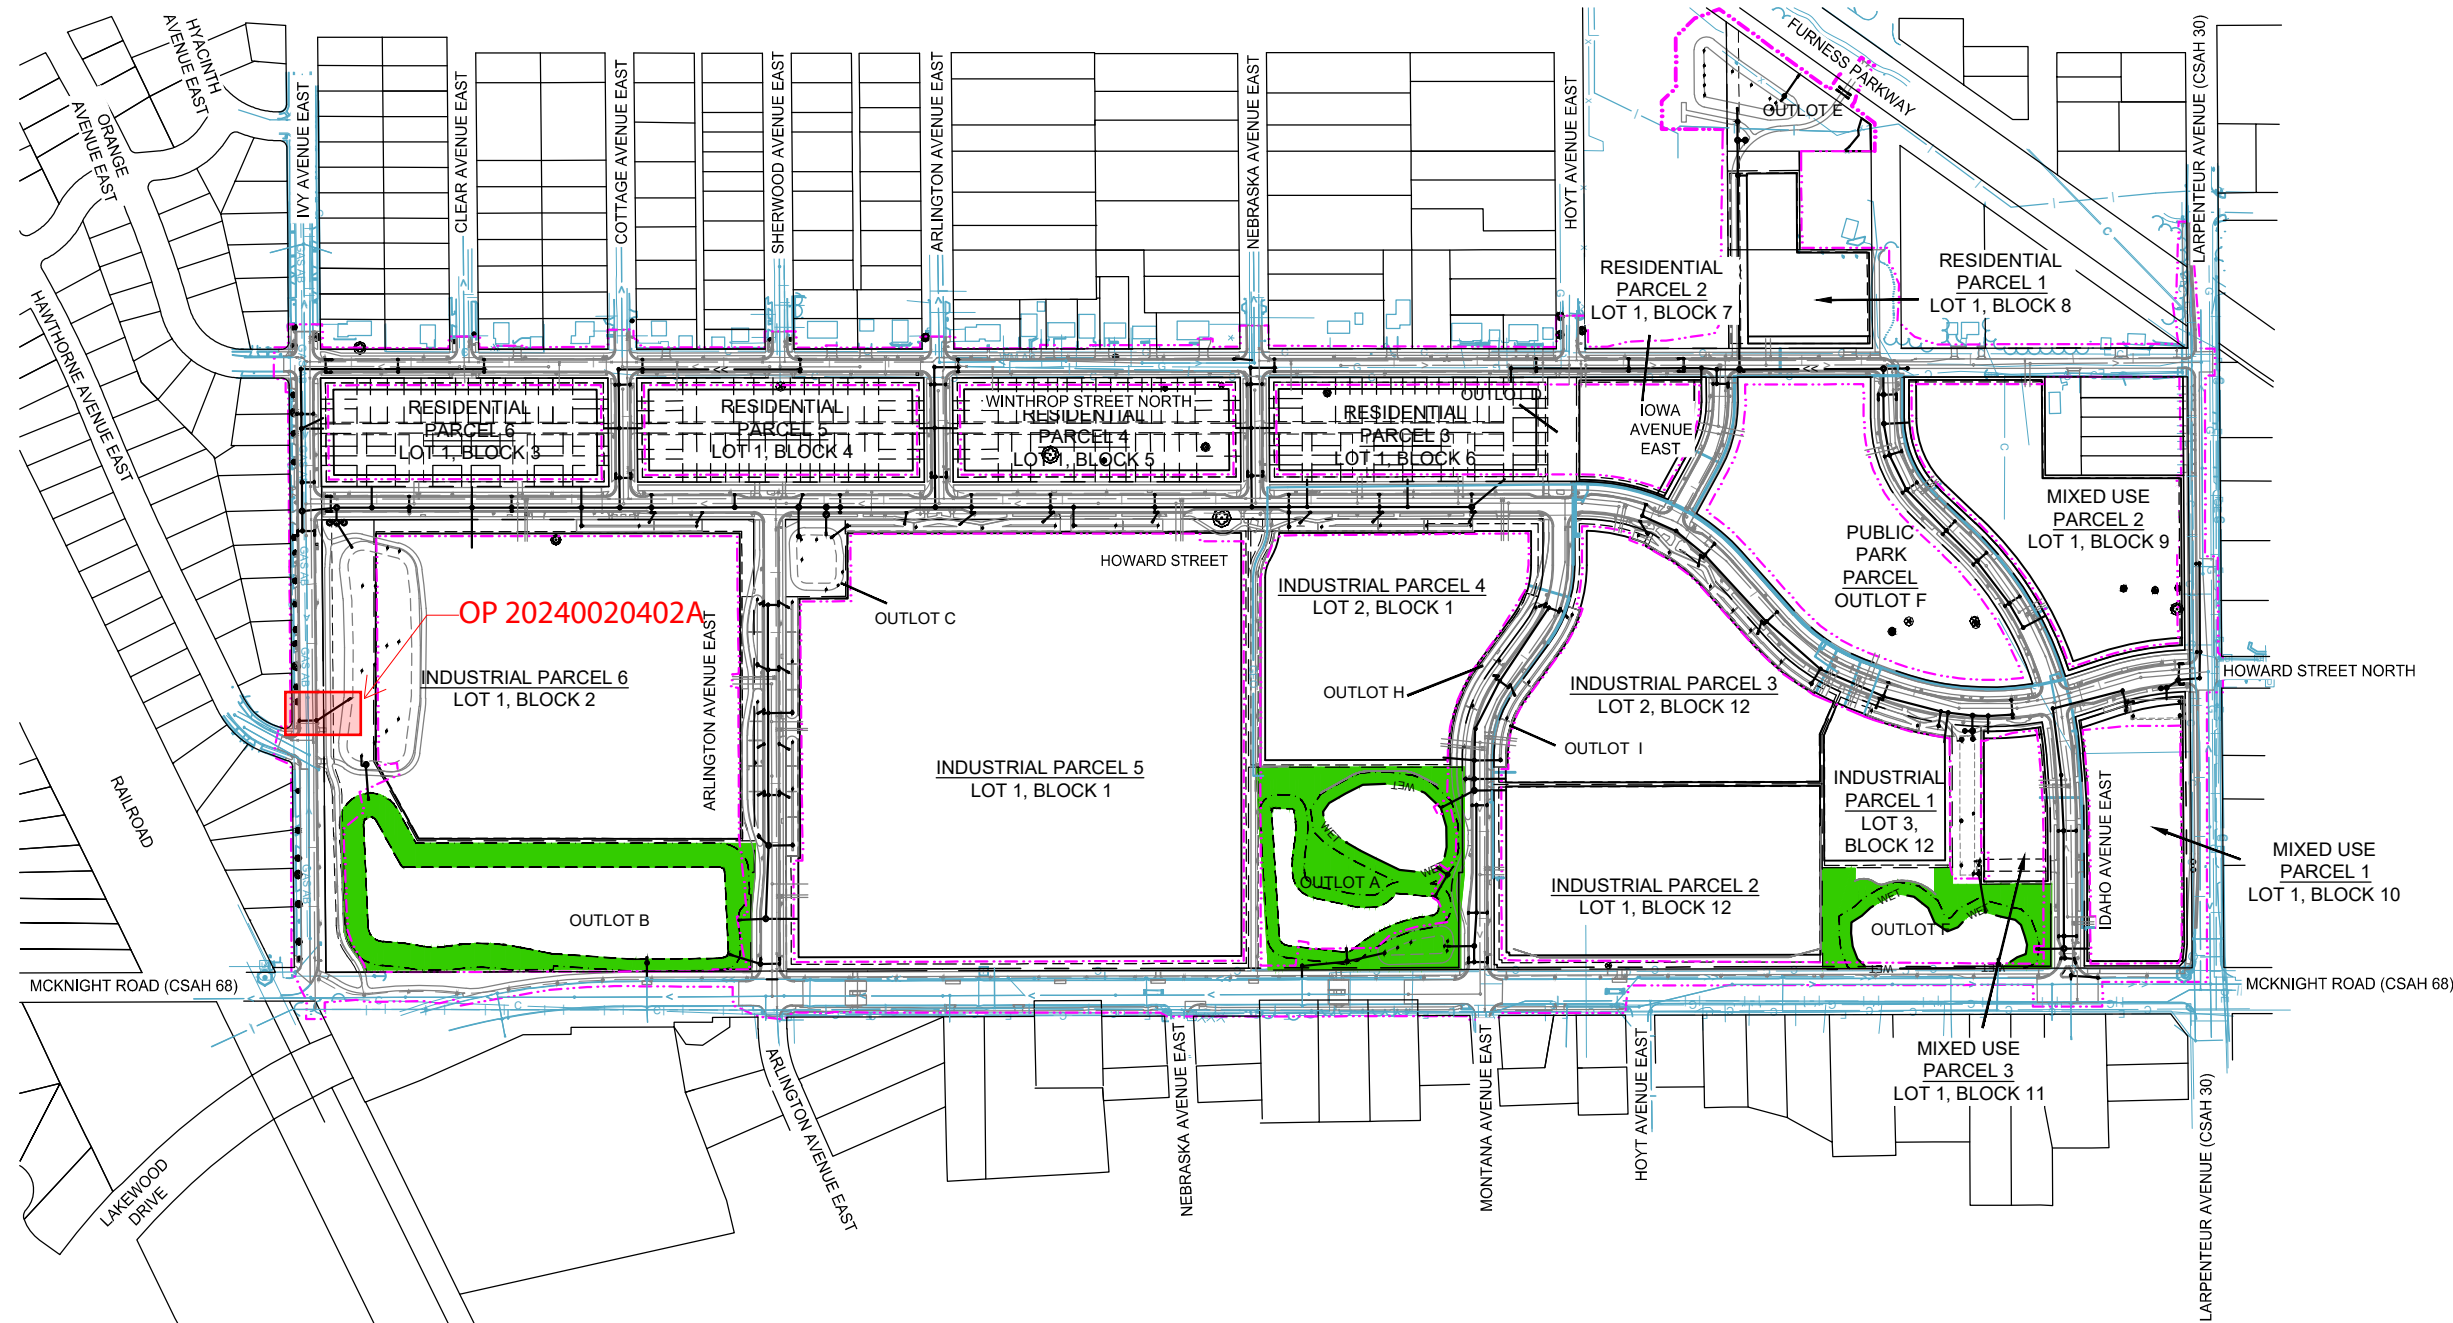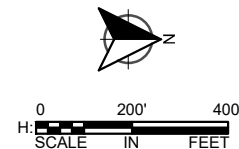

K:\013987-000\CadPlan\SUBMITTAL\013987-000-C-STRM-PLAN-XING.dwg 10/16/2024 4:11:48 PM

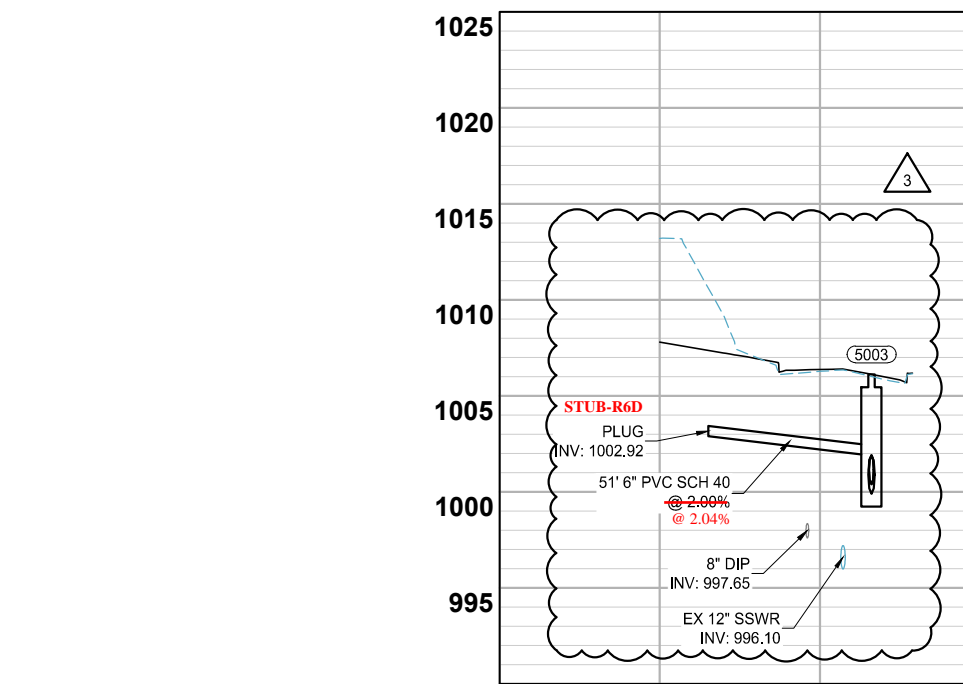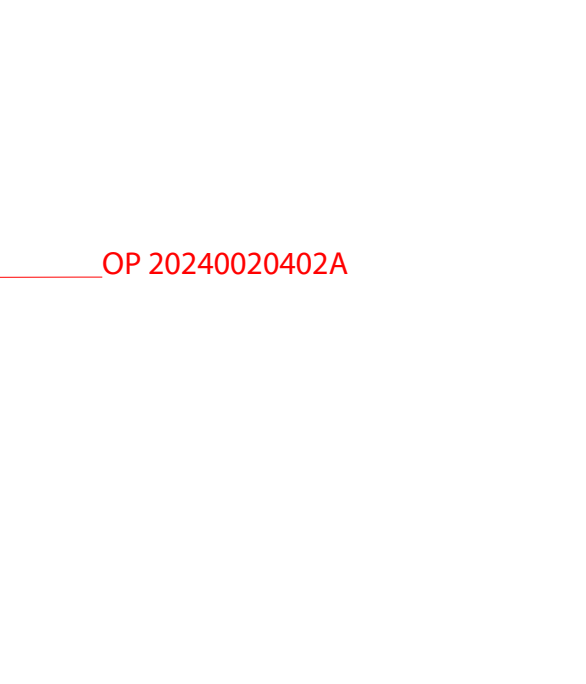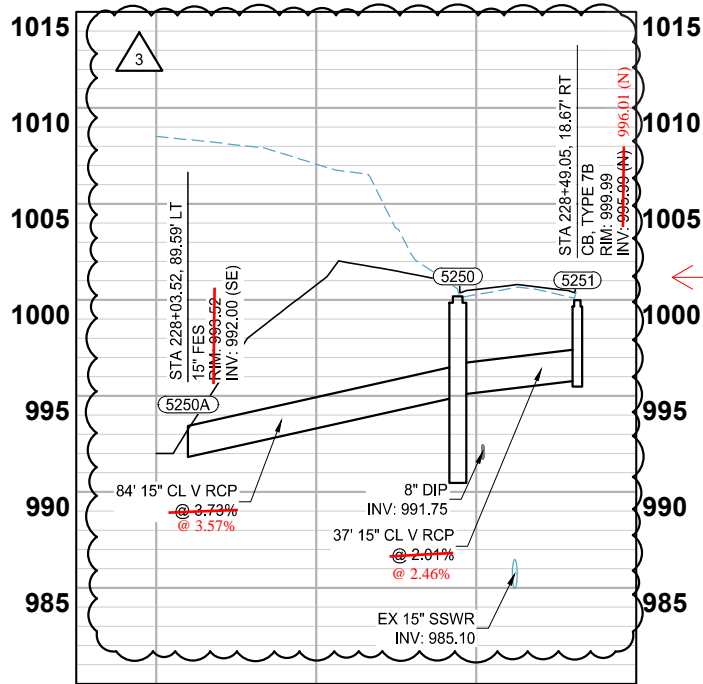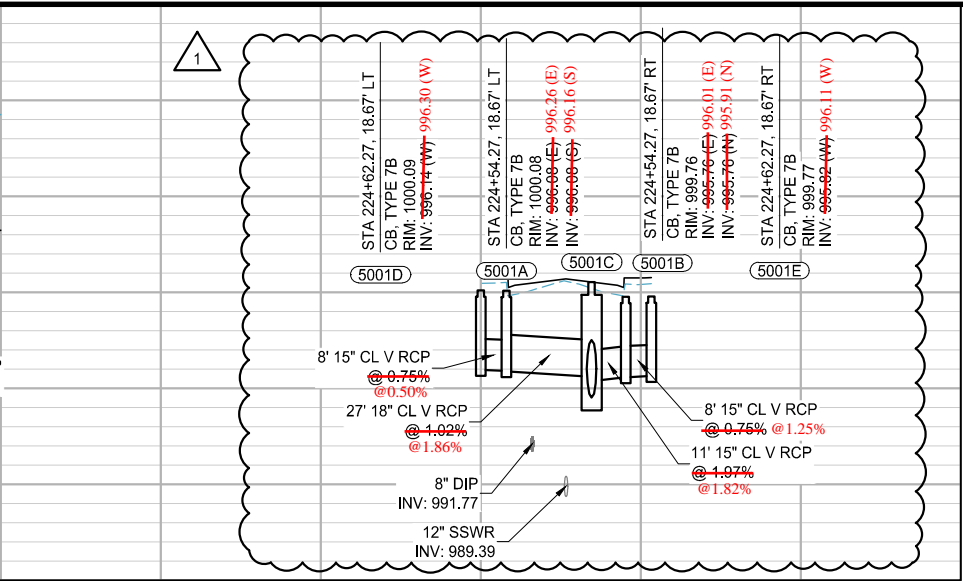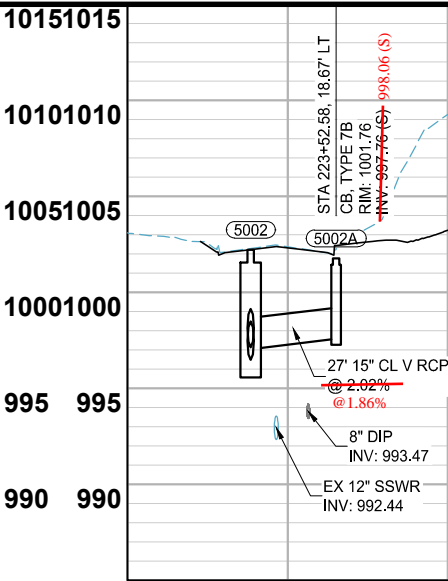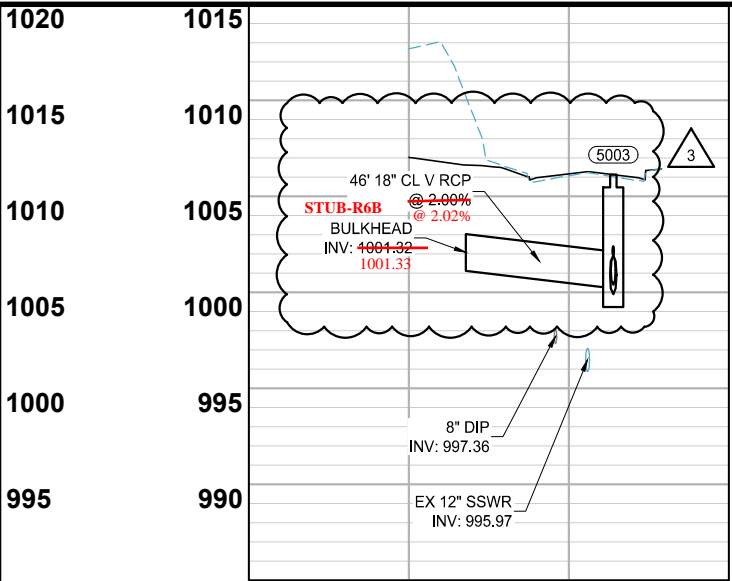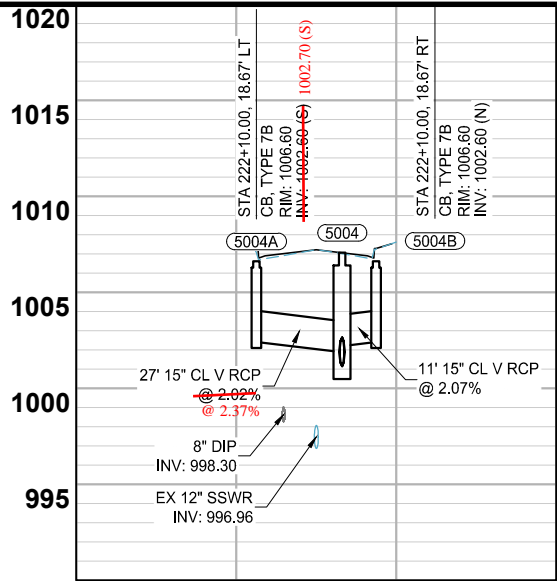

SCALE:		DESIGN BY:	
AS SHOWN		PJM	
PLAN BY:		CHECK BY:	
DEH		PTH	
REVISIONS	NO.	DATE	DESCRIPTION
	1	01/30/2024	ADDENDUM NO. 1
	3	03/29/2024	PLAN REVISIONS

I HEREBY CERTIFY THAT THIS PLAN, SPECIFICATION, OR REPORT WAS PREPARED BY ME OR UNDER MY DIRECT SUPERVISION AND THAT I AM A DULY LICENSED PROFESSIONAL ENGINEER UNDER THE LAWS OF THE STATE OF MINNESOTA.

PAUL HORNB, P.E.
DATE: 03/29/2024 LIC. NO: 23359

STORM SEWER CONSTRUCTION

INFRASTRUCTURE PLANS FOR:
THE HEIGHTS
SAINT PAUL, MINNESOTA

I HEREBY CERTIFIED THAT THIS RECORD DRAWING HAS BEEN PREPARED UNDER MY DIRECT SUPERVISION AND THAT I AM A DULY LICENSED PROFESSIONAL ENGINEER UNDER THE LAWS OF THE STATE OF MINNESOTA. THIS DRAWING HAS BEEN PREPARED IN PART, BASED UPON INFORMATION FURNISHED BY OTHERS. WHILE THIS INFORMATION IS BELIEVED TO BE RELIABLE, BOLTON & MENK, INC. CANNOT ASSURE ITS ACCURACY. THOSE RELYING ON THIS DOCUMENT ARE ADVISED TO OBTAIN INDEPENDENT VERIFICATION OF ITS ACCURACY BEFORE APPLYING IT FOR ANY PURPOSE.

ASHLEIGH K ROSA
LICENSE #: 59517

5-30-2025
DATE

Saint Paul
Port Authority
400 Wabasha Street North
Suite 240
St Paul, Minnesota 55102
Phone 612-224-5686

WSB PROJECT NO.
013987-000