

# EXHIBIT A (2 PAGES)

Abandoned sewer line in vacated Bidwell Street and crossing the northwesterly corner of Block 187, Robertson's Addition to West Saint Paul.


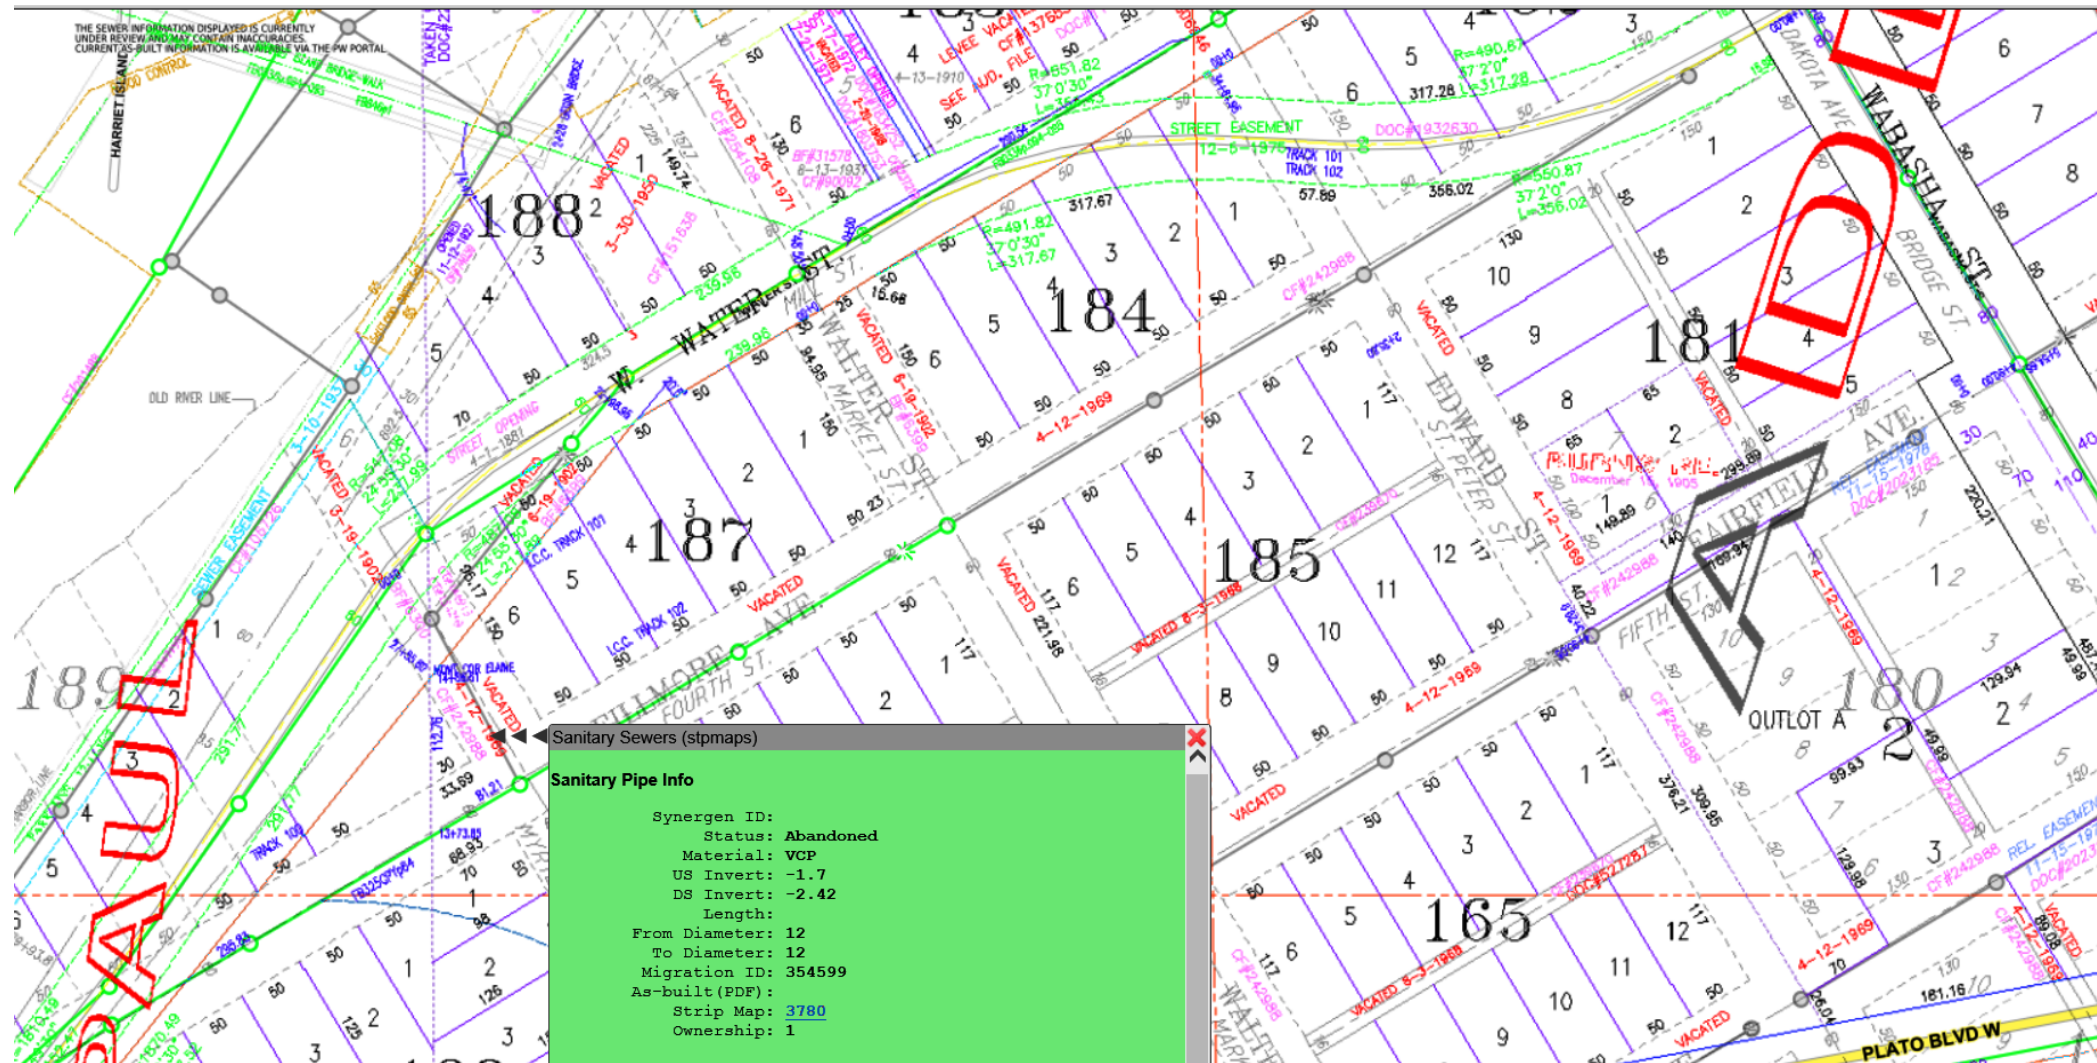


EXHIBIT A (2 PAGES)

# Water St.

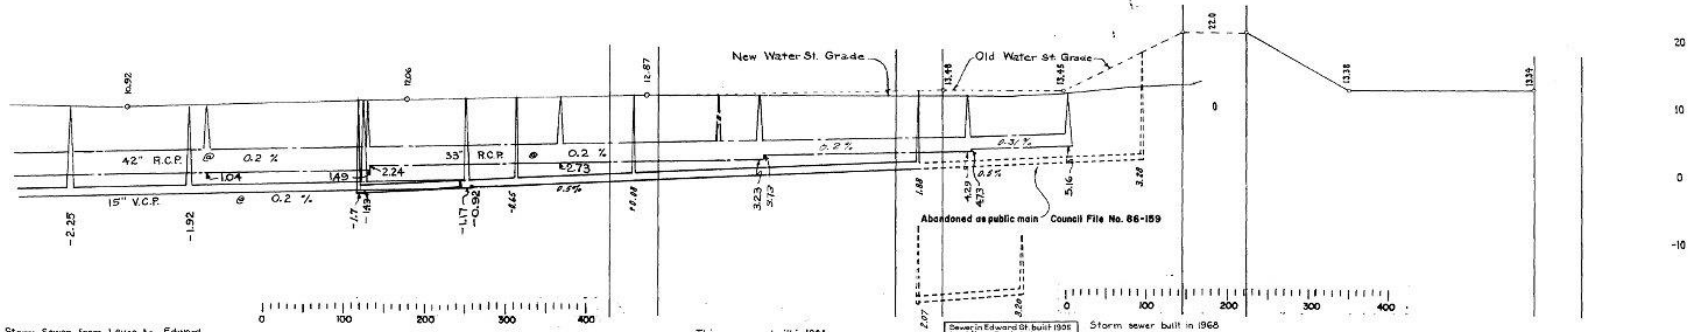

Storm Sewer from Lovce to Edward & 15" Sanitary Sewer from Moses to the 12" sewer was built in 1955-56. Cont. P.314-D-1. Book 544 Pg.2.

This sewer was built in 1904 Contract No. 728 from grade to So. Wabasha Book 261 page 70. See E.C.S. - Relations Add. B. 103.

Sewer in Edward St. built 1905 by City. Book 261 p. 77. Abandoned as public main Council File No. 86-159.

Storm sewer built in 1956 From Walter to So. Wabasha Cont. G7-P-493.

