

Exhibit A

Ordinance Permit 20200010604

Exhibit H

Form of Public Infrastructure Conveyance

PUBLIC INFRASTRUCTURE CONVEYANCE

ORDINANCE PERMIT # 20200010604

This Public Infrastructure Conveyance Agreement (“Agreement”) is made and entered into effective November 8, 2021, by and between PROJECT PAUL, LLC, a Delaware limited liability company (“Developer”), and CITY OF SAINT PAUL, MINNESOTA, a municipal corporation existing under the laws of the State of Minnesota (“City”).

NOW, THEREFORE, in consideration of the mutual obligations of the parties hereto, each of them does hereby covenant and agree as follows:

1. Notification. The Developer has delivered to the City a duly executed Certificate of Completion and, thereafter, the City has determined that the applicable components of the Public Infrastructure as described in **Exhibit A** hereto (the “Infrastructure”) appear to have been constructed in accordance with the approved plans and specifications and the preliminary and final plat and has so notified the Developer in writing. As a result, via this Agreement, the Developer is conveying the Property to the City in accordance with the Site Improvement Performance Agreement, dated December 19, 2019. The acceptance of the Infrastructure does not take effect until the Saint Paul City Council accepts the Infrastructure via Resolution.

2. Representations. The Developer hereby represents, certifies, and promises to the City the following:

- (a) With respect to the Property, Developer has complied with the provision of the Redevelopment Agreement, dated December 19, 2019, including that the Property conveyed to the City in this Agreement is completely constructed, constructed in compliance with all applicable Standards as described in the St. Paul Department of Public Works’ Construction of Infrastructure by Private Developers Policy, is free of defects, and is free and clear of any encumbrances or liens.
- (b) A final walk-through inspection with appropriate City staff has been completed and any required corrective work (written punch list) determined through said walk-through or as determined under the normal and ordinary course of on-site observations by City staff or those hired by the City to complete such observations, has been completed.
- (c) The following documents respecting the Property are complete, accurate, and have been filed with the appropriate department(s) of the City of Saint Paul:
 - (i) Original, reproducible As-Built Plans acceptable to the Department of Public Works, City of Saint Paul are on file with said Department.
 - (ii) Certificate of Completion signed by Engineer of Record who is a licensed Professional Engineer with the State of Minnesota per Minnesota State Statute 326.

[Exhibit N to Site Improvement Performance Agreement (Ford Site)]

- (iii) For sewer systems, video records of televised inspections of sewer mains have been submitted by permittee and approved by Sewer Utility staff.
 - (iv) For sewer systems, sewer connection permit information on file with Public Works.
 - (v) Operation and Maintenance plans.
 - (vi) All other permit requirements as set forth in the Ford site ordinance permit policy.
- (d) Developer has undertaken any and all necessary actions to assign warranties it owns or possesses on or with the Property to the City.
 - (e) Developer will duly execute and deliver any other documents as may be reasonably and customarily required in connection with the transfer of the Property to the City.

3. Conveyance. The Developer hereby dedicates, conveys and assigns in good title to the City of Saint Paul, together with all hereditaments and appurtenances all rights, entitlements, benefits, permits, approvals, and licenses that pertain to, with, or in the Property in its entirety, without reservation or exception, together with all warranties, free and clear of any mortgage, pledge, hypothecation, encumbrance, lease, license, lien or others security interest. If necessary, Developer shall execute a recordable Warranty Deed to be recorded with the Ramsey County Registrar's Office.

IN WITNESS WHEREOF, the City and Developer have caused this Agreement to be duly executed in their names and on their behalf, all on or as of the date first above written.

PROJECT PAUL, LLC,
a Delaware limited liability company

By: Ryan Companies US, Inc., a Minnesota corporation, its Sole Member

By: 
Name: MAUREEN C. MICHALSKI
Its VICE PRESIDENT

STATE OF Minnesota)
) ss.
COUNTY OF Hennepin)

The foregoing instrument was acknowledged before me this 8th day of November, 2021 ^{BR} ~~2019~~, by Maureen Michalski, the Vice President of Ryan Companies US, Inc., a Minnesota corporation, the Sole Member of Project Paul, LLC, a Delaware limited liability company, on behalf of the limited liability company.


Notary Public



[Exhibit N to Site Improvement Performance Agreement (Ford Site)]



CITY OF SAINT PAUL DEPARTMENT OF PUBLIC WORKS

Certificate of Compliance

I hereby certify that work completed under this Ordinance Permit and materials provided for installation conform to the appropriate specifications and provisions of and the Department of Public Works, City of Saint Paul, Minnesota, *Standard Supplemental Specifications for Construction of Public Infrastructure by Private Developers Policy*, as amended, and that I am a duly Licensed Professional Engineer under the laws of the State of Minnesota.

SANITARY ORDINANCE PERMIT NO. 4

Project Description

20200010604

Permit Number

ERIK W. MILLER PE, MN 41326 9/16/2021

(Signature and License No.)

Date

SAMBATEK, INC.

Organization (Print)

1/2012

September 16, 2021

Will Rollo
Project Manager I
Ryan Companies
533 South Third Street, Suite 100
Minneapolis, MN

Dear Mr. Rollo:

As a part of the Highland Bridge Phase I ROW infrastructure construction, we have reviewed information provided by Ryan Companies through the project's Procore document management website pertaining to Sanitary Ordinance Permit No. 4, Permit Number 20200010604. This information consists of daily site observation reports prepared by Kimley Horn, daily reports and material tests prepared by Braun Intertec, and daily reports prepared by Ryan Companies. Additionally, we have reviewed the sanitary air test logs, deflection logs and televising reports provided by Kimley Horn and record plans completed by Sambatek.

Based upon this information, we find that the utility improvements included within Sanitary Ordinance Permit No. 4 have been generally constructed in conformance with the Ford Site Redevelopment Plans and Specifications dated May 27, 2020 and subsequent revisions.

Sambatek has not completed any visual inspection of said improvements and rely that the information provided by the Contractor is accurate and correct. Punchlist or corrective work has been coordinated through Ryan Companies and Kimely Horn on-site representatives.

Please contact me at 612-703-0735 or emiller@sambatek.com with any questions.

Sincerely,



Erik W. Miller PE
Senior Client Service Manager



CITY OF ST PAUL
 Department of Public Works
 25 West 4th Street
 1500 City Hall Annex
 Saint Paul, MN 55102

ORDINANCE PERMIT

OFFICE USE ONLY
 Application No. 4
 Application Date 7/6/2020
 SPR File # _____
 Permit No. 20200010604

Type of Permit (select one only):

- | | | |
|---|--|--|
| <input type="checkbox"/> Base Roadway | <input type="checkbox"/> Roadway Sidewalks | <input checked="" type="checkbox"/> Sanitary Sewer Collection System |
| <input type="checkbox"/> Bridge | <input type="checkbox"/> Roadway Traffic | <input type="checkbox"/> Storm Sewer Collection System |
| <input type="checkbox"/> Retaining Wall | <input type="checkbox"/> Sanitary Drop Shaft | <input type="checkbox"/> Storm Sewer Treatment System |

Phase:

One

Location (Street On, From/To, and Adjacent Lots/Blocks):

Montreal Avenue: STA 166+88.34 East to SSMH #412 (STA 170+47.44).

Description of Work: *[Include the description provided in the permit application and all subsequent amendments or revisions, which are hereby incorporated by reference.]*

The scope of work to be installed under Sanitary Sewer Ordinance Permit #4 is the furnishing and installation of all sanitary sewer piping, sanitary stubs and structures in the areas identified in the locations section above along with the attached "Sanitary Sewer OP #4 Exhibit." Estimated quantities of piping based on material type, sizing, and structures based on size can be seen as an attachment to this application labeled "SS OP#4 SEQ." Applicable plan sheets related to this permit are listed below and attached to this application: 108-109


Applicant Contact Person: Will Rollo	Contact Person Title: Sr. Project Engineer	Contact Person Telephone: 612-257-3536	Contact Person Email: will.rollo@ryancompanies.com
Bond Co.: Travelers Casualty & Surety Co		Bond Amount: \$73,609,974.00	Bond No.: 107185400
Insurance Co.: Zurich American Insurance Company		Insurance Certificate No.: NA	

Permit Conditions:

This permit is issued with the stipulation that the work of the permittee and related agents, employees and contractors shall conform in all respects to the Redevelopment Agreement (including all Legal Requirements as defined by Article 1), the City of Saint Paul Department of Public Works Ordinance Permit Process Document, and the Department of Public Works List of Applicable Standards & Specifications. The permit shall be available for display at the site referred to herein and shown to any Police Officer or Inspector upon demand and does not authorize or allow for interference with the work of any Contract made or to be made with the City of Saint Paul.

**THIS PERMIT MAY BE REVOKED AT ANY TIME
 BY THE DIRECTOR OF PUBLIC WORKS**

A PERMIT FOR THE ABOVE DESCRIBED CONSTRUCTION IS AUTHORIZED BY:

	City Technical Lead	7/14/2020
Signature	Title	Date
David Kuebler, P.E.		
Printed Name		

PERMIT NUMBER 20200010603

**ITEMS TO BE COMPLETED PRIOR TO ACCEPTANCE OF INFRASTRUCTURE
AND RELEASE OF PERMIT**

Prior to acceptance of any infrastructure and release of City permits, the following items must be completed to the satisfaction of the City:


- Corrective (punch list) work completed;
- Original reproducible CAD and PDF as-built plans, signed by the Engineer of Record, provided to Public Works; Submittal of final copies of Metropolitan Council Environmental Services and MN Pollution Control Agency Permits (Sewer Extension, SAC Determination, etc.);
- Full compliance with project Quality Management Plan or other document(s) governing quality management and quality assurance;
- Documentation of compliance with all applicable City and non-City permit requirements, including, but not limited to: City Public Works Right-of-Way Office, Minnesota Pollution Control Agency, Capitol Region Watershed District, and National Pollution Discharge Elimination System permit requirements;
- NA Documentation of roadway materials at compaction of grading and base, plant mix design report, strength;
- Video of all sanitary sewer mains and laterals, storm sewer mains and laterals, and any structural BMP's (pipe galleries, draintile, sediment control structures, weir structures, etc.) installed under any permit, provided to the Public Works Sewer Division;
- Sewer Permit drawings for paving connections or stubs installed to service vertical development provided to Public Works, in addition to Private Service Lateral Permit Drawings;
- NA Documentation of Public Works notified for signal and lighting inspection of pole field layouts (staking), conduits and foundations installed, poles and wiring installed, and head positioning and phasing/detection verification (signals only);
- NA For infrastructure within parks: Documentation that Parks Department has been notified of completion status;
- NA All applicable operation and maintenance manuals provided to Public Works; and
- Certificate of Compliance signed and submitted to City by Engineer of Record.

RELEASE OF PERMIT:



Permit No. _____ Council Res. No. _____ Permit Date _____

Release Authorized by _____ Title _____

SANITARY SEWER OP #4 EXHIBIT
7/6/2020

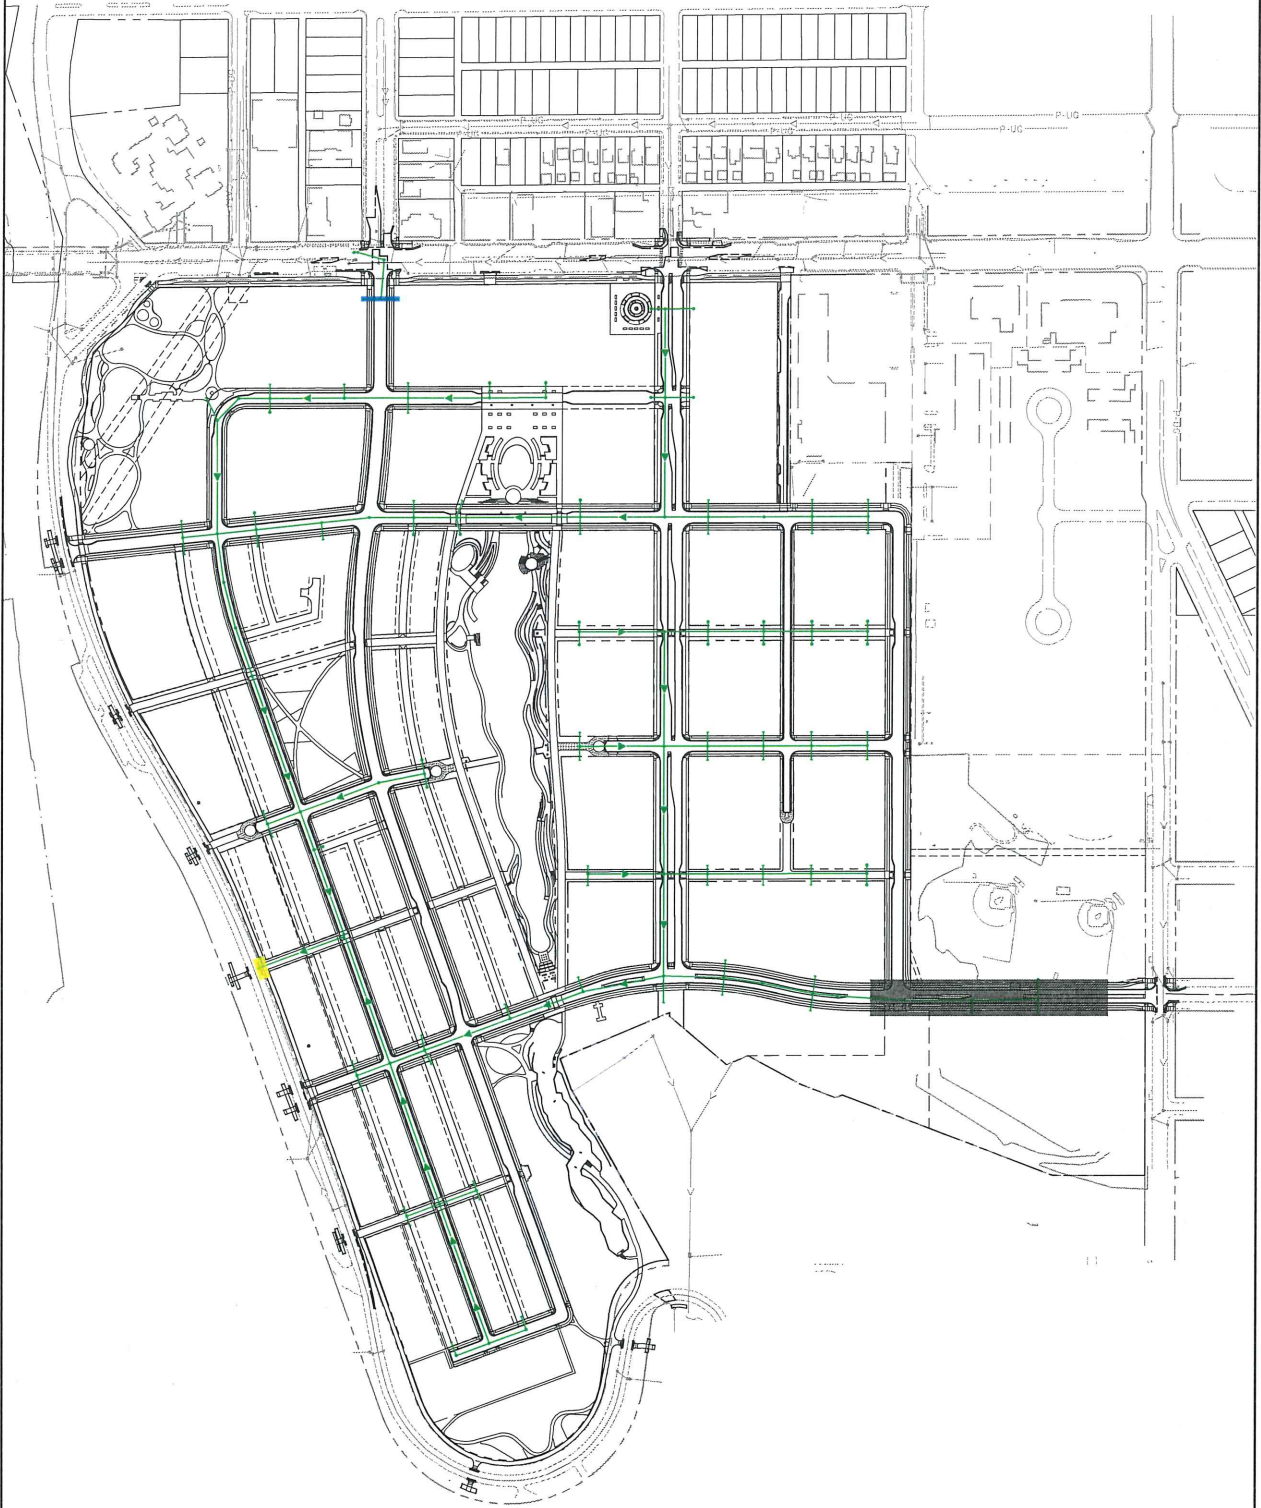

OP SERIES 4 ■

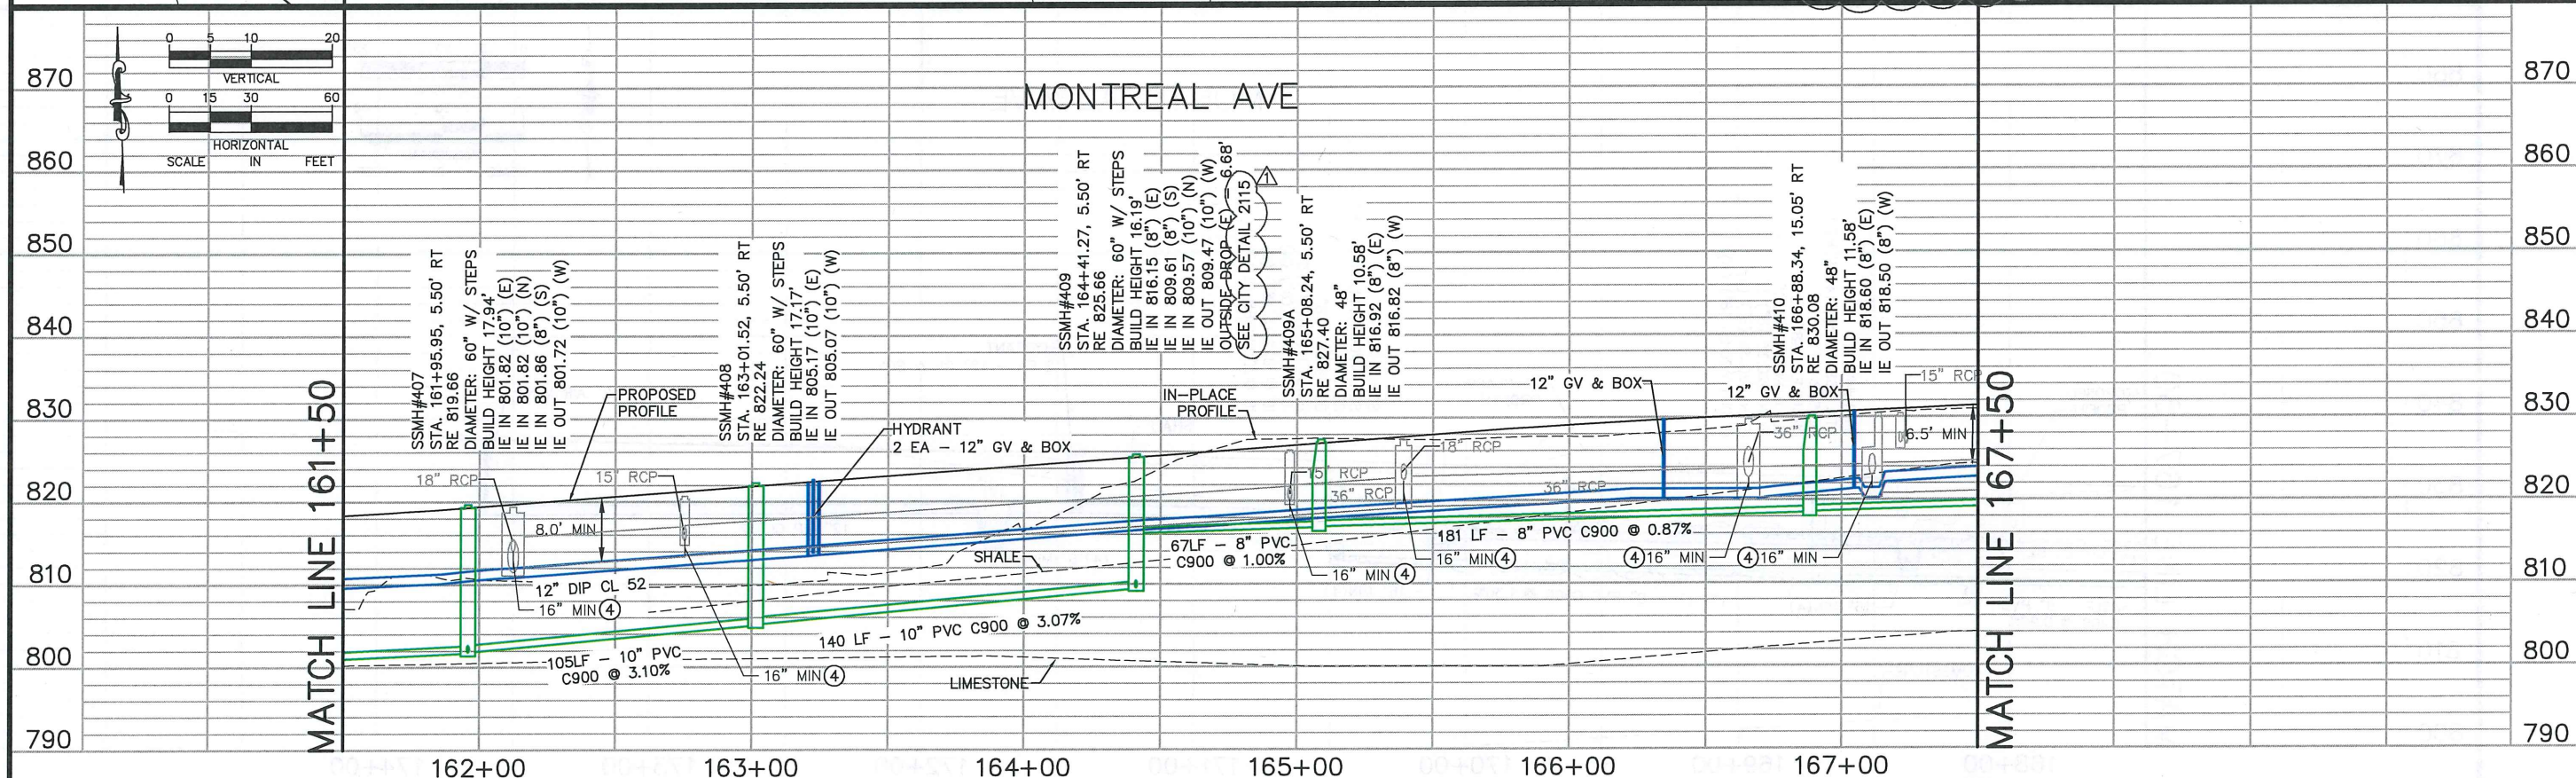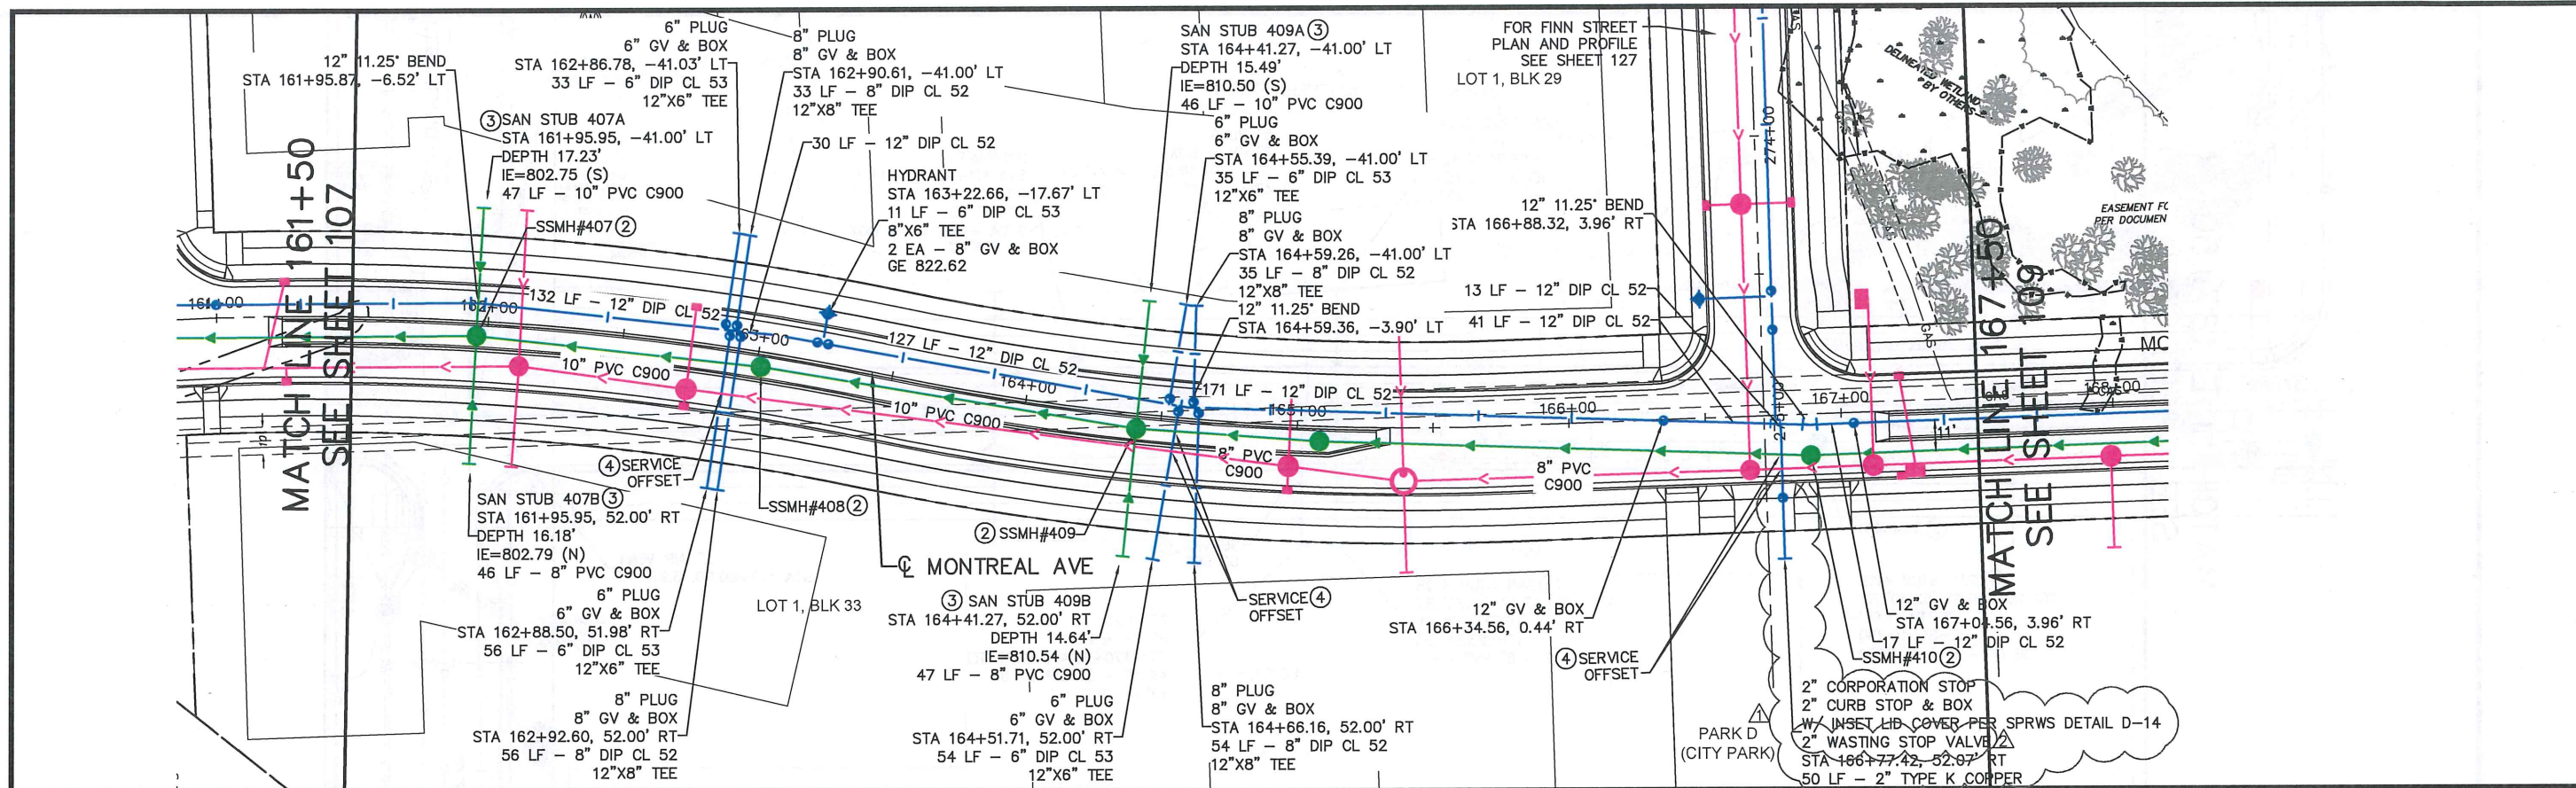

No.	Date	Revisions	App.
1	06/17/20	BULLETIN #1	EWM
2	07/01/20	BULLETIN #2	EWM

App.	DRAWING NAME
EWM	Ford UtilPlanProfile EW.dwg
EWM	DESIGNED BY: RJG
	DRAWN BY: RJG
	CHECKED BY: GSB
	DATE: 05/27/20
	PROJECT NO. 160640016

Kimley»Horn


Sambatek

I HEREBY CERTIFY THAT THIS PLAN, SPECIFICATION OR REPORT WAS PREPARED BY ME OR UNDER MY DIRECT SUPERVISION AND THAT I AM A DULY LICENSED PROFESSIONAL ENGINEER UNDER THE LAWS OF THE STATE OF MINNESOTA.

Erik W. Miller



ERIK W. MILLER, PE

DATE: 01/21/2020 MN LIC. NO. 41326

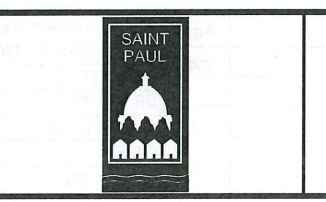

RYAN COMPANIES US, INC.
 FORD SITE REDEVELOPMENT
 CITY OF ST PAUL, MINNESOTA
 FINAL SITE PLAN
 MONTREAL AVE
 SANITARY SEWER AND WATERMAIN
 PLAN AND PROFILE
 STA. 161+50 TO STA. 167+50

SHEET NO.
108
522

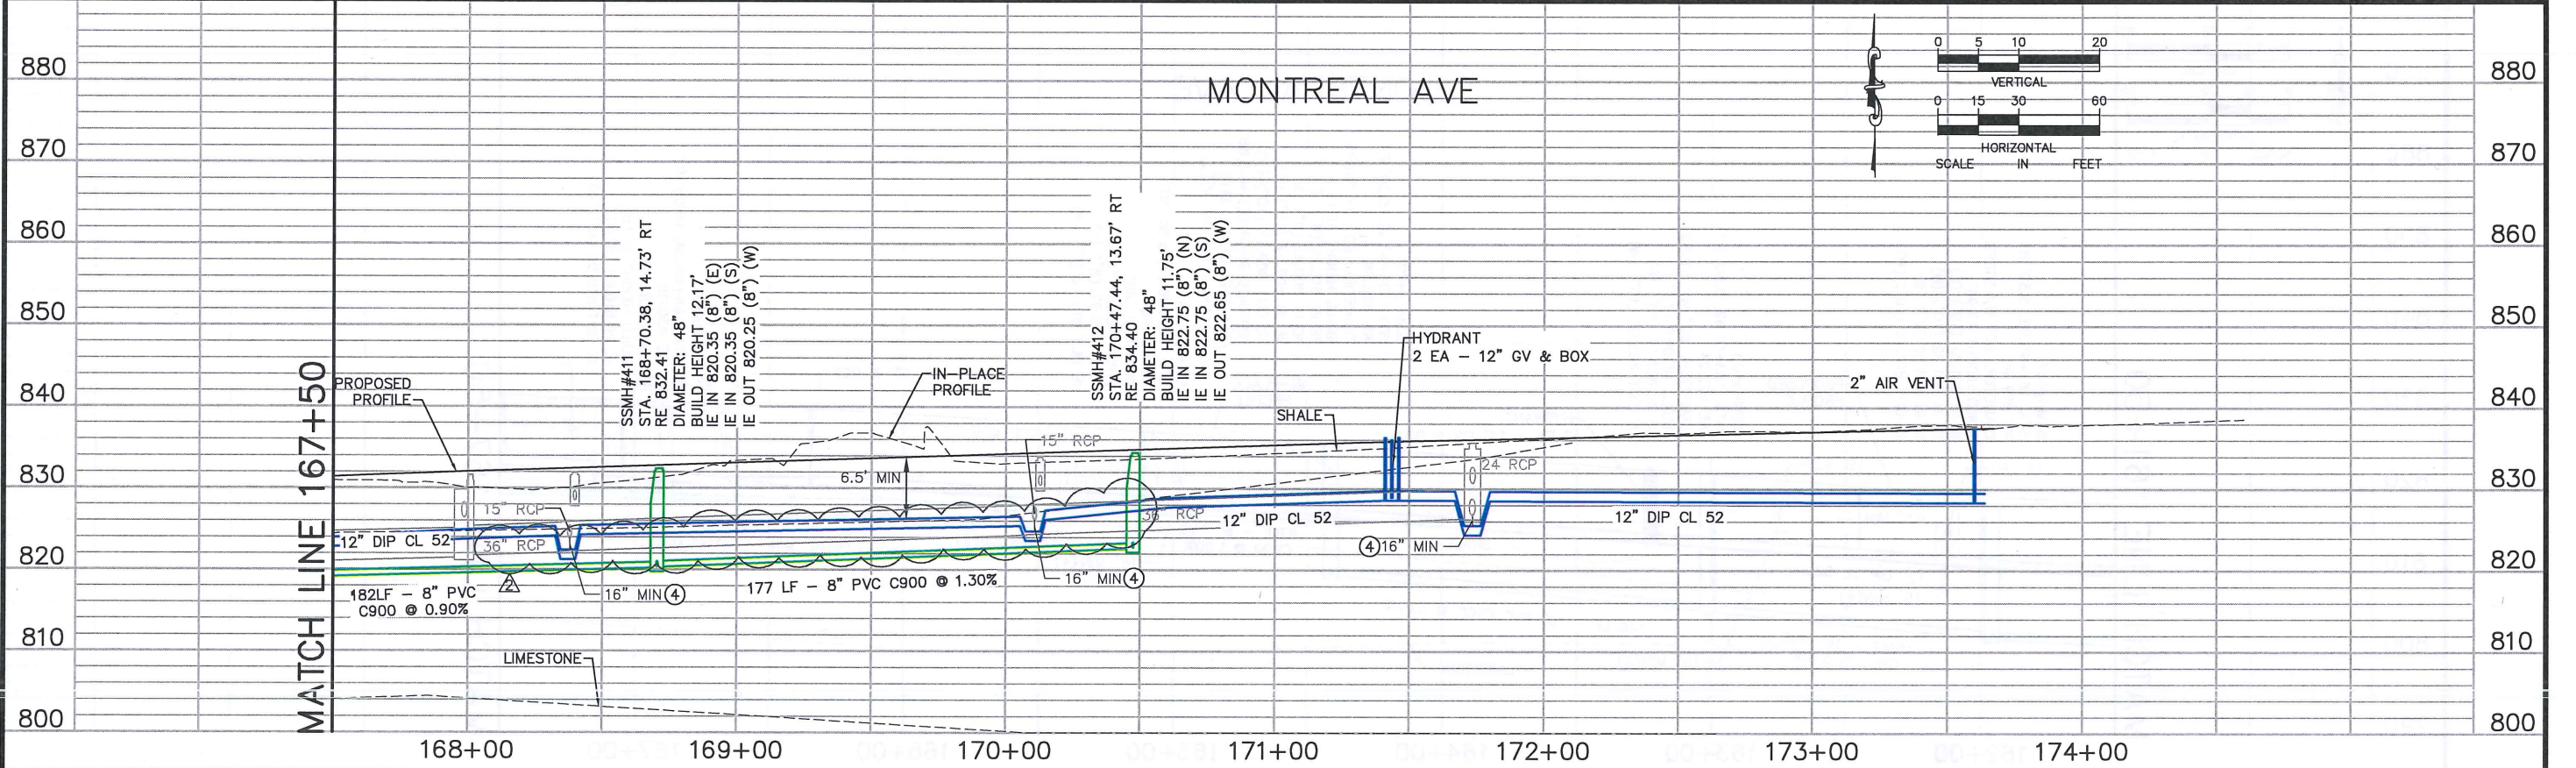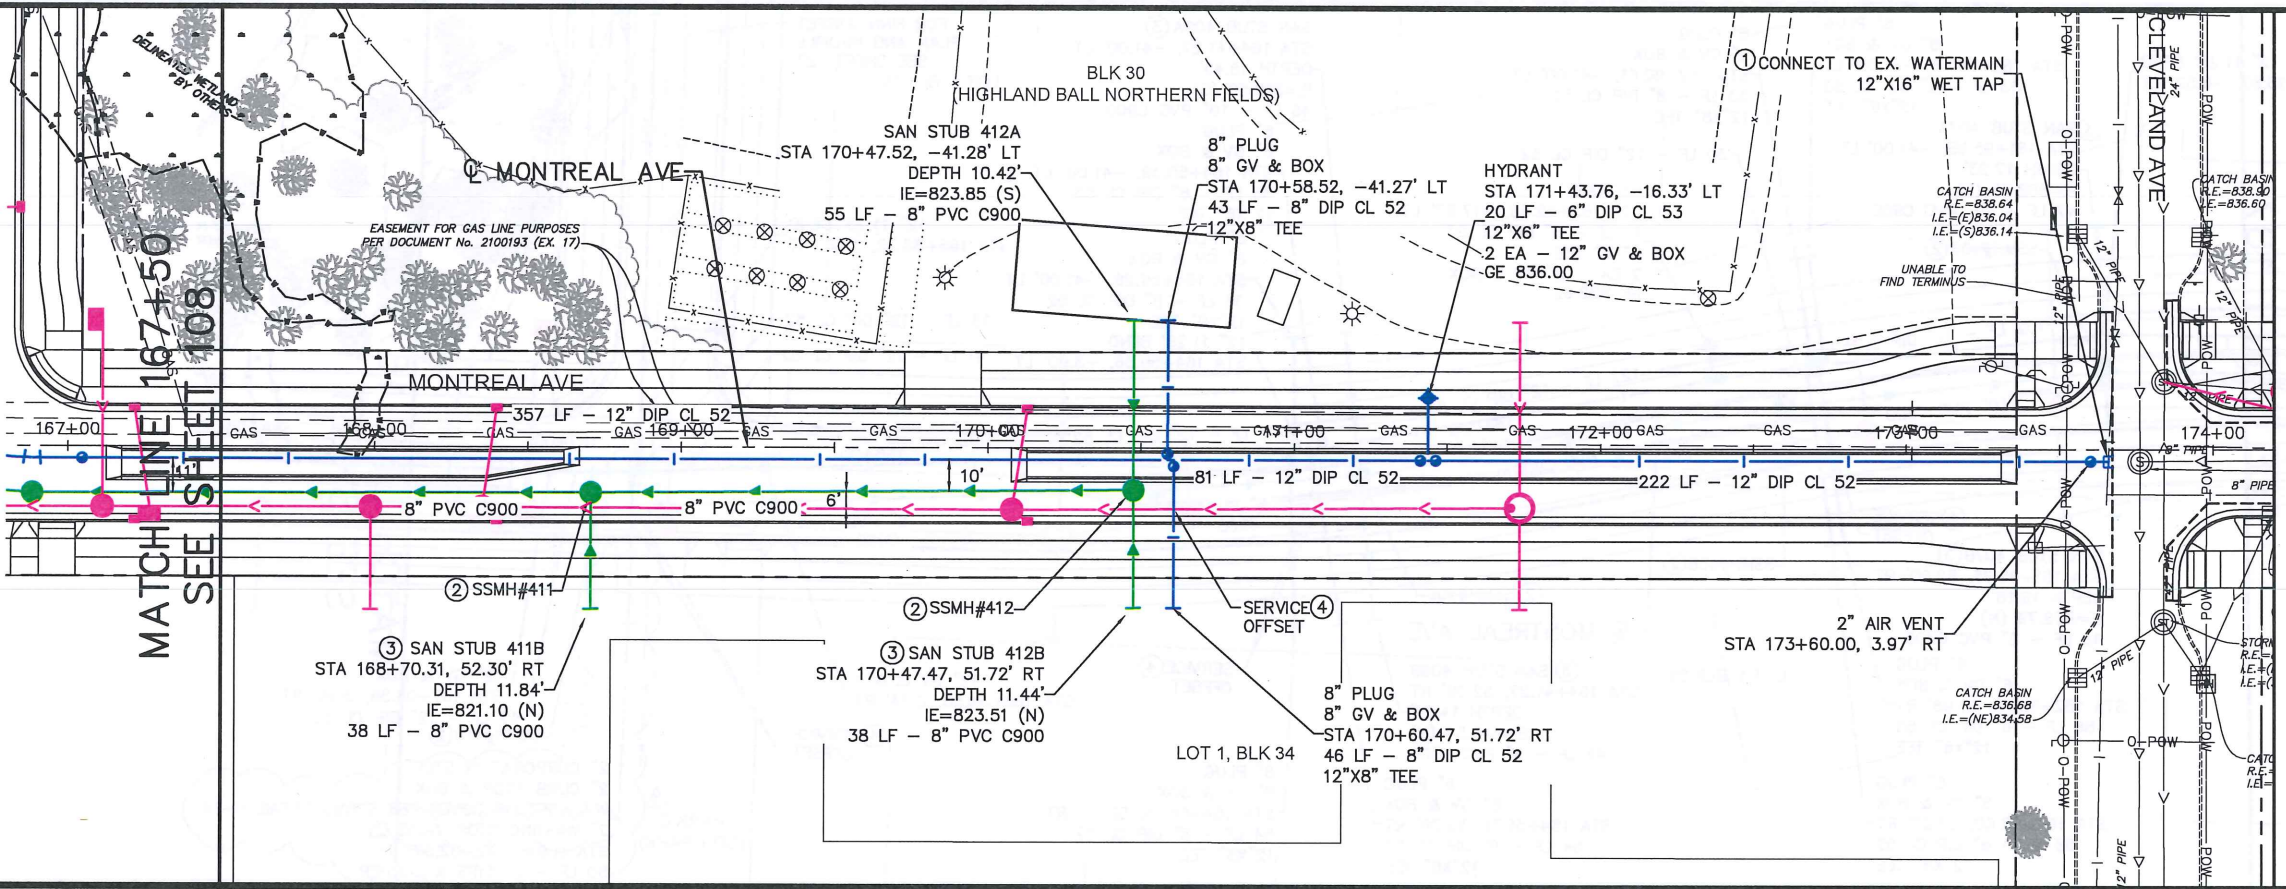


No.	Date	Revisions	App.	DRAWING NAME
2	07/01/20	BULLETIN #2	EWM	Ford UtilPlanProfile EW.dwg
				DESIGNED BY: RJG
				DRAWN BY: RJG
				CHECKED BY: GSB
				DATE: 05/27/20
				PROJECT NO. 160640016

Kimley»Horn
Sambatek

I HEREBY CERTIFY THAT THIS PLAN, SPECIFICATION OR REPORT WAS PREPARED BY ME OR UNDER MY DIRECT SUPERVISION AND THAT I AM A DULY LICENSED PROFESSIONAL ENGINEER UNDER THE LAWS OF THE STATE OF MINNESOTA.

Erik W. Miller
ERIK W. MILLER, PE
DATE: 01/21/2020_MN LIC. NO. 41326

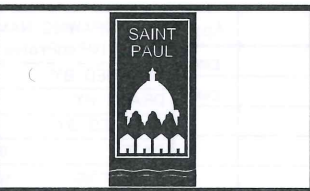

RYAN COMPANIES US, INC.
FORD SITE REDEVELOPMENT
CITY OF ST PAUL, MINNESOTA
FINAL SITE PLAN
MONTREAL AVE
SANITARY SEWER AND WATERMAIN
PLAN AND PROFILE
STA. 167+50 TO STA. 173+76

SHEET NO.
109
522