


..... Ramsey County

••• Metropolitan Council

North

Retaining Walls

Exhibit F


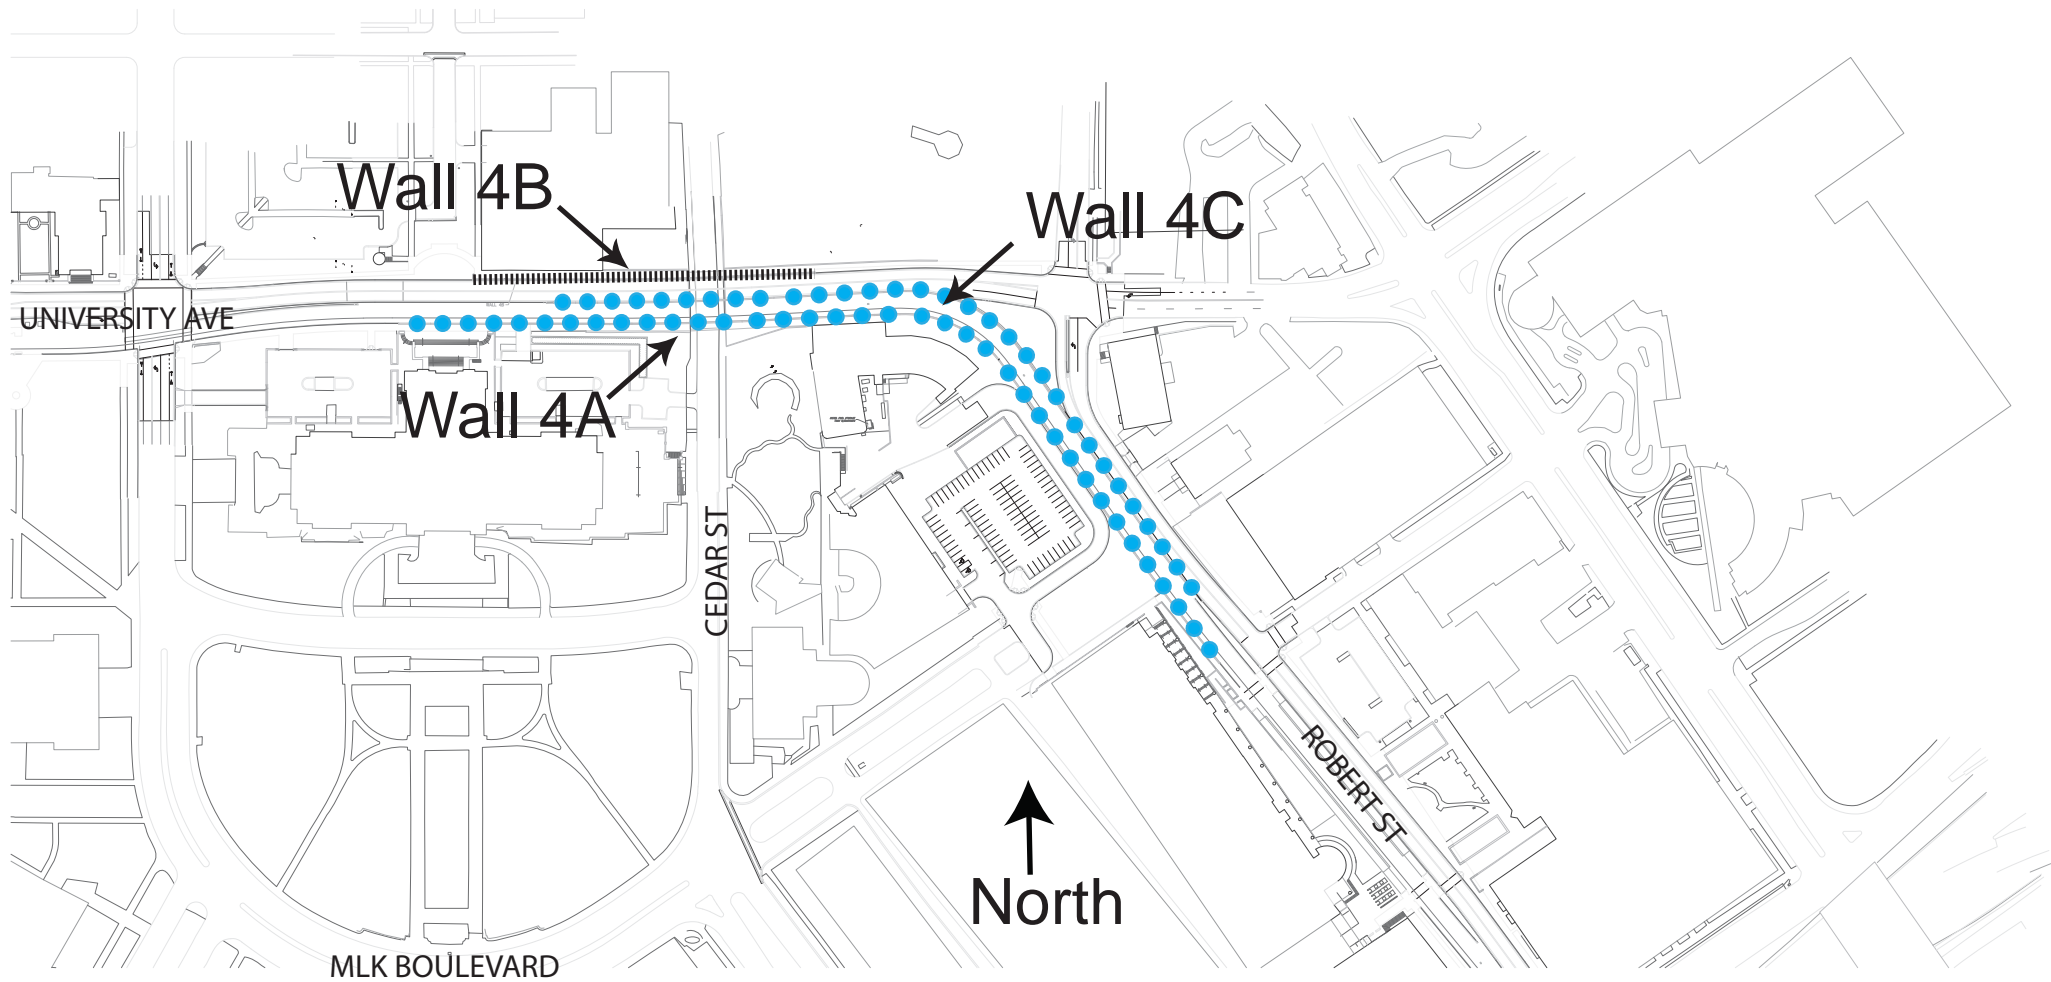


..... Ramsey County

... Metropolitan Council

Retaining Walls/Fences

Exhibit F

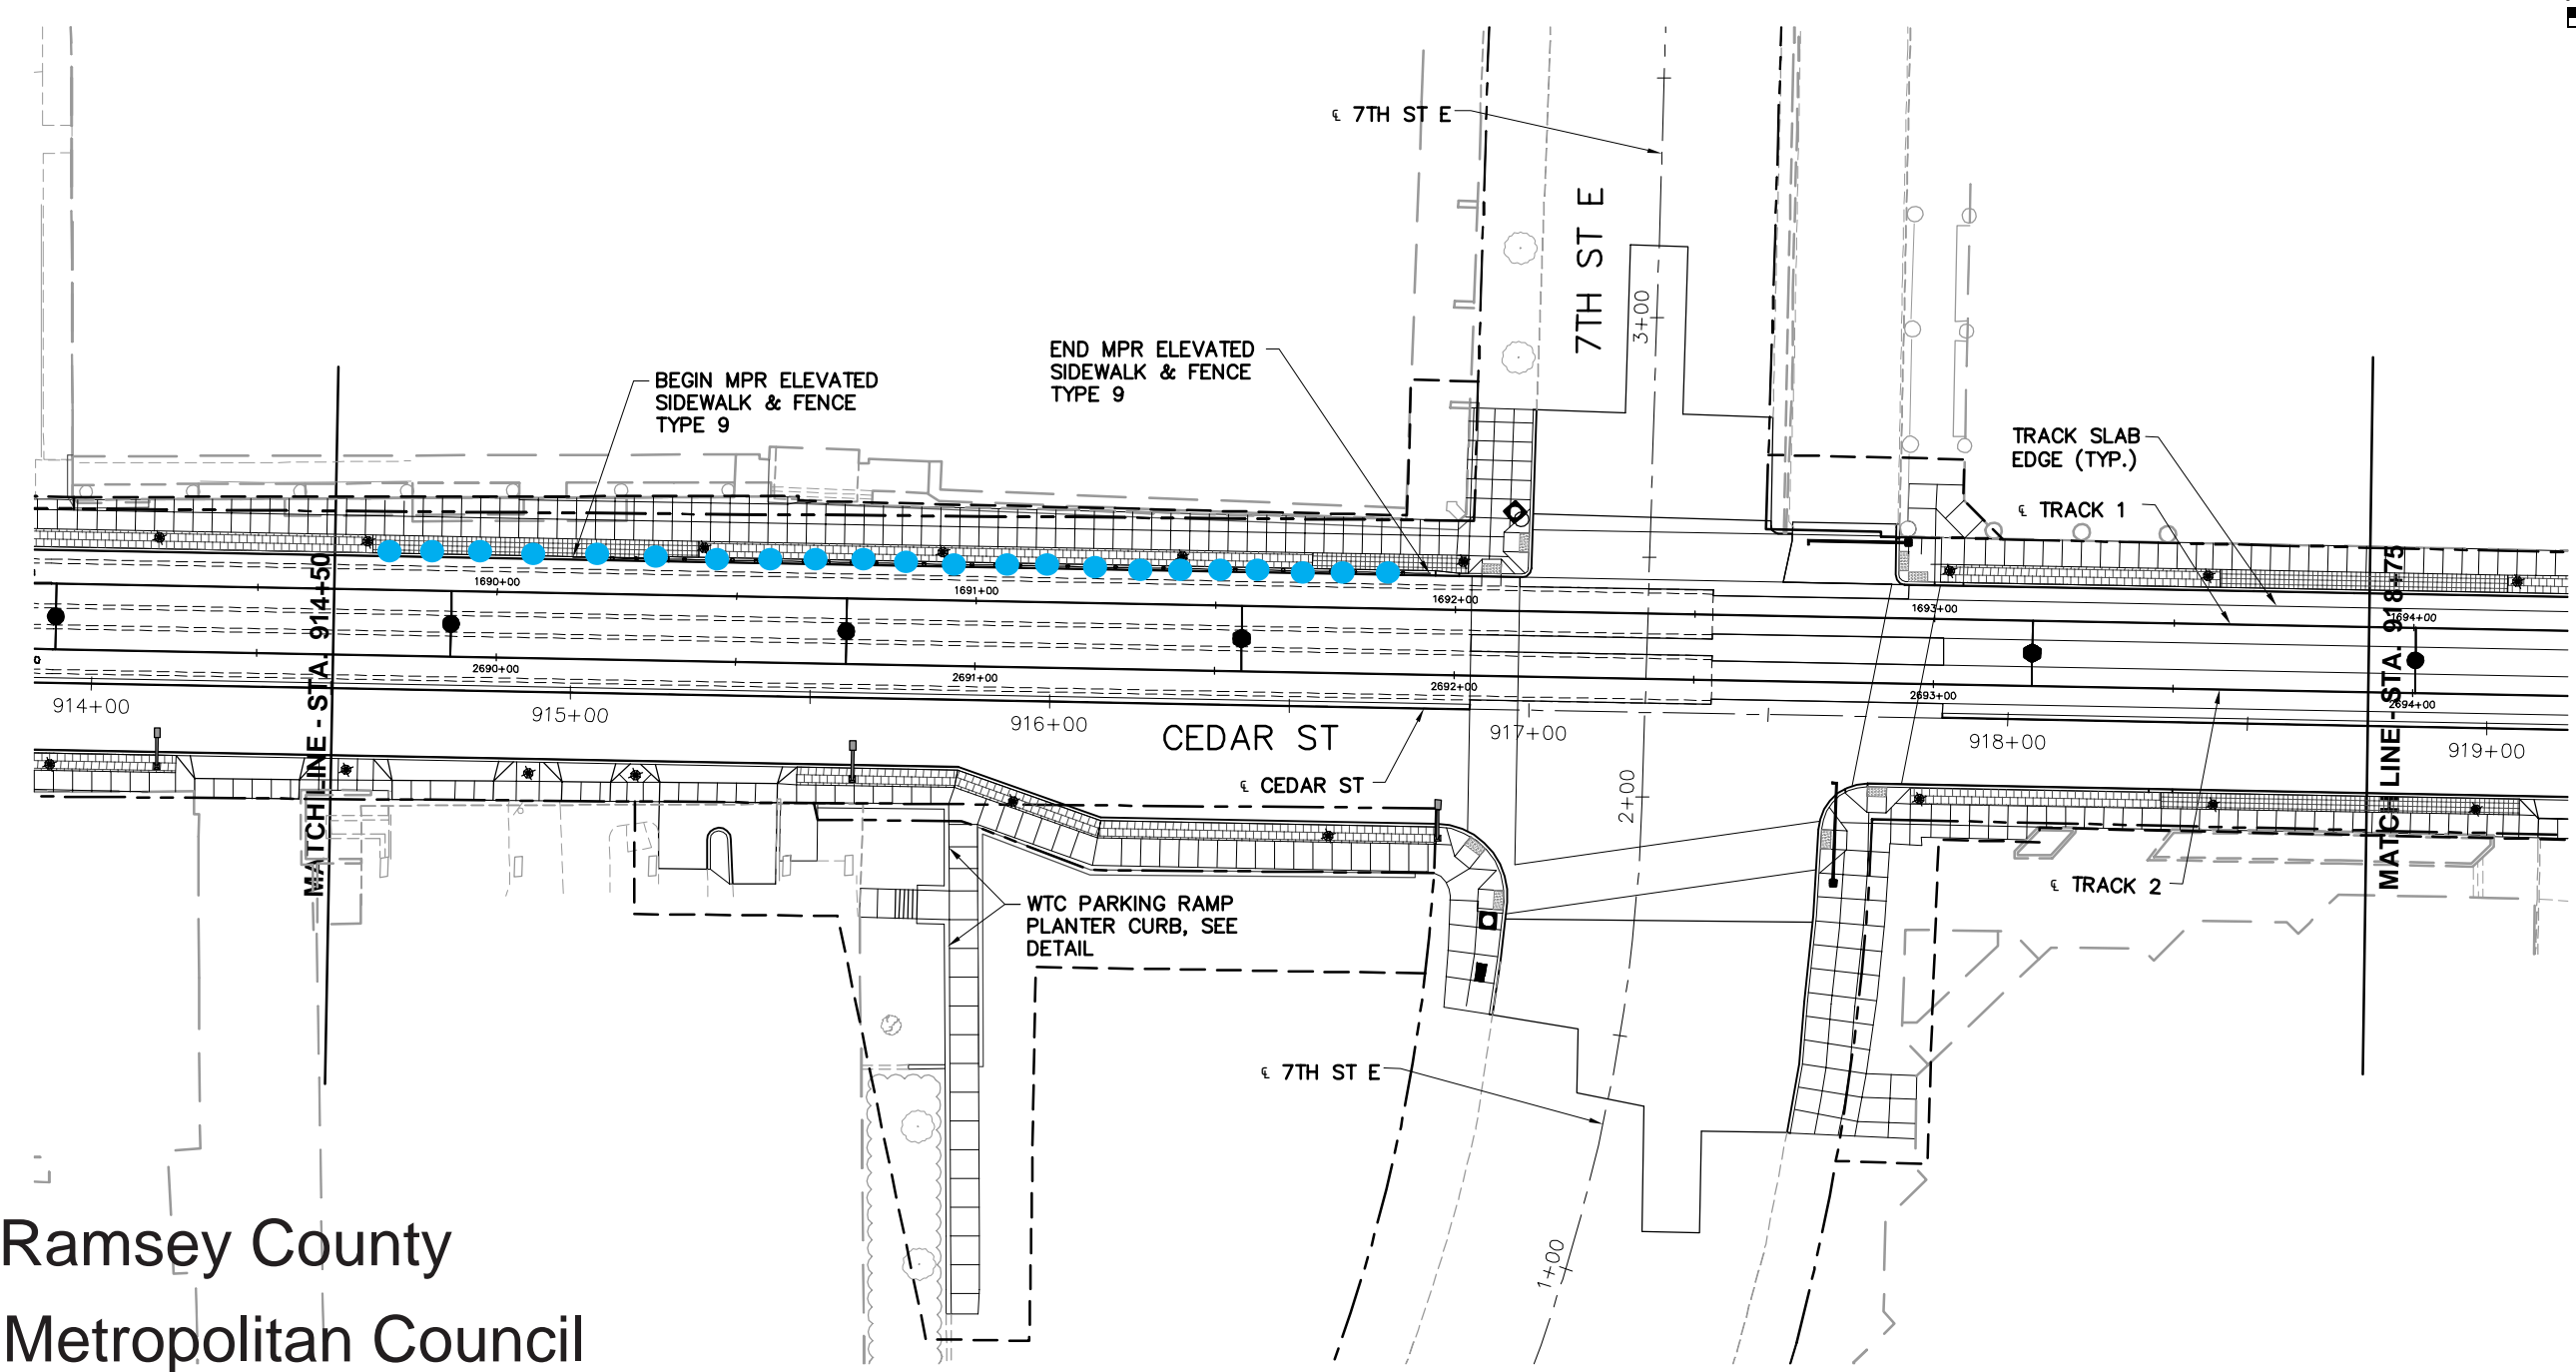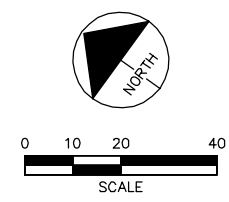

- ▬▬▬▬▬▬▬▬ Ramsey County
- Metropolitan Council

Retaining Walls/Fences

Exhibit F

Nov. 27 2013 07:33 am I:\900_CAD\SEGMENT-04 (STP)\SHEET\LAND\URD\URD-E-PLN-076.dwg By: nicole.guick

NO.	DATE	BY	CHECK	DESIGN	REVISION / SUBMITTAL
.
.
.
.
A	07/30/2013	RBC	TPH	TPH	AS-BUILT SHEET
2	04/06/2012	ALA	TPH	TRH	ADJUSTED PAVER BAND FOR TURN LANE
1	03/31/2010	ALA	TPH	TRH	ADDENDUM NO. 2 - SIDEWALK JOINTS
0	02/24/2010	ALA	TPH	TRH	ISSUED FOR BID


THESE RECORD DOCUMENTS HAVE BEEN PREPARED BASED ON INFORMATION PROVIDED BY OTHERS TO SHOW THE REPORTED LOCATION OF THE WORK AND SIGNIFICANT CHANGES MADE DURING THE CONSTRUCTION PROCESS. BECAUSE THESE RECORD DOCUMENTS ARE BASED ON UNVERIFIED INFORMATION PROVIDED BY OTHER PARTIES, AECOM AND ITS SUBCONTRACTORS CANNOT AND DO NOT WARRANT THEIR ACCURACY OR COMPLETENESS, AND SHALL NOT BE RESPONSIBLE FOR ANY ERRORS OR OMISSIONS THAT MAY BE INCORPORATED HEREIN AS A RESULT. SIMILARLY, AECOM AND ITS SUBCONTRACTORS ARE NOT RESPONSIBLE FOR THE MEANS OR METHODS OF CONSTRUCTION OR "AS-BUILT" CONSTRUCTION THAT DIFFERS FROM SIGNED AND SEALED DESIGN DRAWINGS. THE PLACING OF ANY PROFESSIONAL SEAL AND THE SIGNATURE OF THE ENGINEER ON THESE RECORD DOCUMENTS ARE SUBJECT TO THE FOREGOING DISCLAIMER OF RESPONSIBILITY AND LIABILITY.



AECOM





Kimley-Horn and Associates, Inc.

Central Corridor
Light Rail Transit


Metropolitan Council

CIVIL EAST CONSTRUCTION - VOLUME 7
URBAN DESIGN PLAN
CEDAR ST 914+50 - 918+75
 DISCIPLINE: **LANDSCAPE ARCH** SHEET NAME: **URD-E-PLN-076**

SHEET
 2711
 OF
 4851

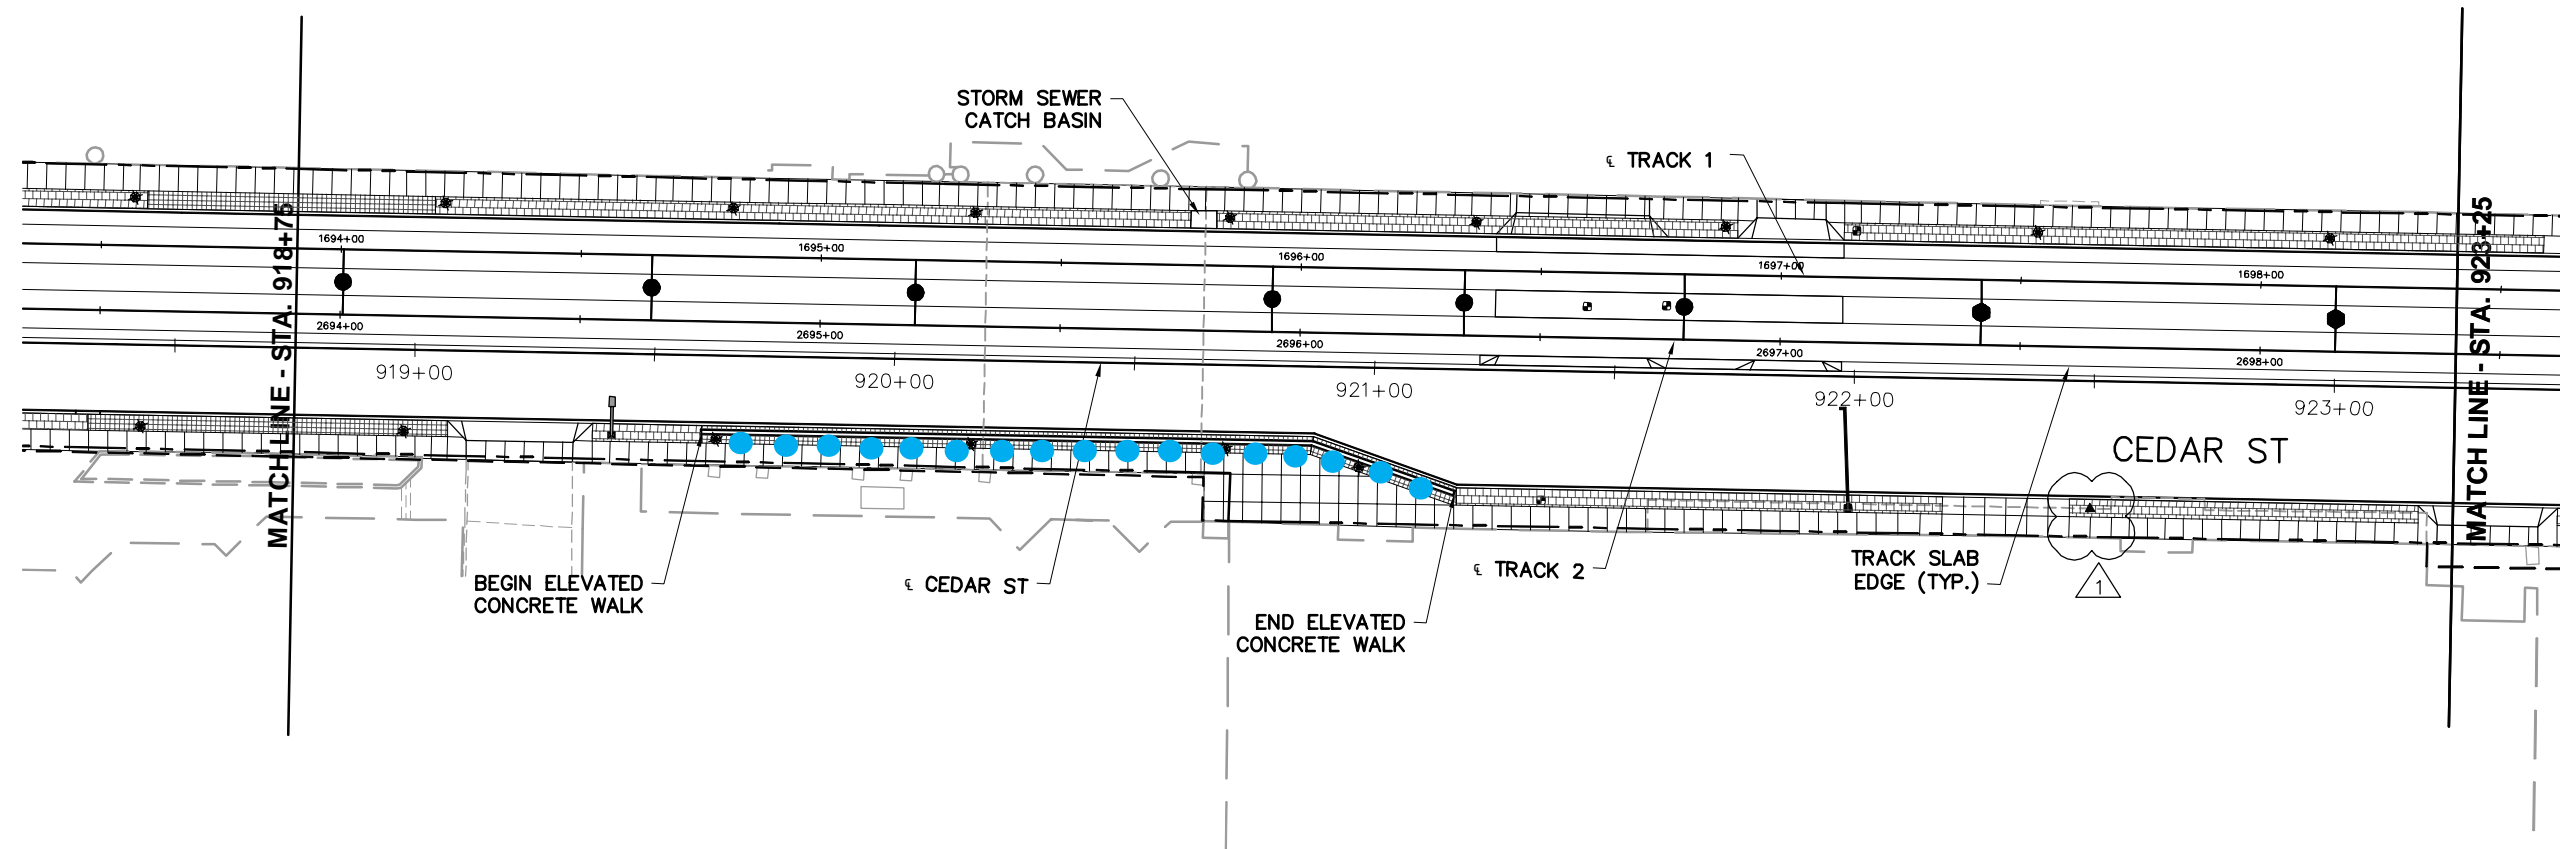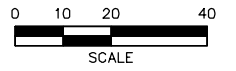

- Ramsey County
- Metropolitan Council

Retaining Walls/Fences

Exhibit F

NO.	DATE	BY	CHECK	DESIGN	REVISION / SUBMITTAL
.
.
A	07/30/2013	RBC	TPH	TPH	AS-BUILT SHEET
1	03/31/2010	ALA	TPH	TRH	ADDENDUM NO. 2 - TRASH RECEPTACLE ADDED
0	02/24/2010	ALA	TPH	TRH	ISSUED FOR BID


THESE RECORD DOCUMENTS HAVE BEEN PREPARED BASED ON INFORMATION PROVIDED BY OTHERS TO SHOW THE REPORTED LOCATION OF THE WORK AND SIGNIFICANT CHANGES MADE DURING THE CONSTRUCTION PROCESS. BECAUSE THESE RECORD DOCUMENTS ARE BASED ON UNVERIFIED INFORMATION PROVIDED BY OTHER PARTIES, AECOM AND ITS SUBCONTRACTORS CANNOT AND DO NOT WARRANT THEIR ACCURACY OR COMPLETENESS, AND SHALL NOT BE RESPONSIBLE FOR ANY ERRORS OR OMISSIONS THAT MAY BE INCORPORATED HEREIN AS A RESULT. SIMILARLY, AECOM AND ITS SUBCONTRACTORS ARE NOT RESPONSIBLE FOR THE MEANS OR METHODS OF CONSTRUCTION OR "AS-BUILT" CONSTRUCTION THAT DIFFERS FROM SIGNED AND SEALED DESIGN DRAWINGS. THE PLACING OF ANY PROFESSIONAL SEAL AND THE SIGNATURE OF THE ENGINEER ON THESE RECORD DOCUMENTS ARE SUBJECT TO THE FOREGOING DISCLAIMER OF RESPONSIBILITY AND LIABILITY.

AECOM



Kimley-Horn
and Associates, Inc.

Central Corridor
Light Rail Transit



Metropolitan Council

CIVIL EAST CONSTRUCTION - VOLUME 7
URBAN DESIGN PLAN
CEDAR ST 918+75 - 923+25

DISCIPLINE: LANDSCAPE ARCH SHEET NAME: URD-E-PLN-077

SHEET 2712 OF 4851