


Ramsey County

Metropolitan Council

Retaining Walls

North

Exhibit F

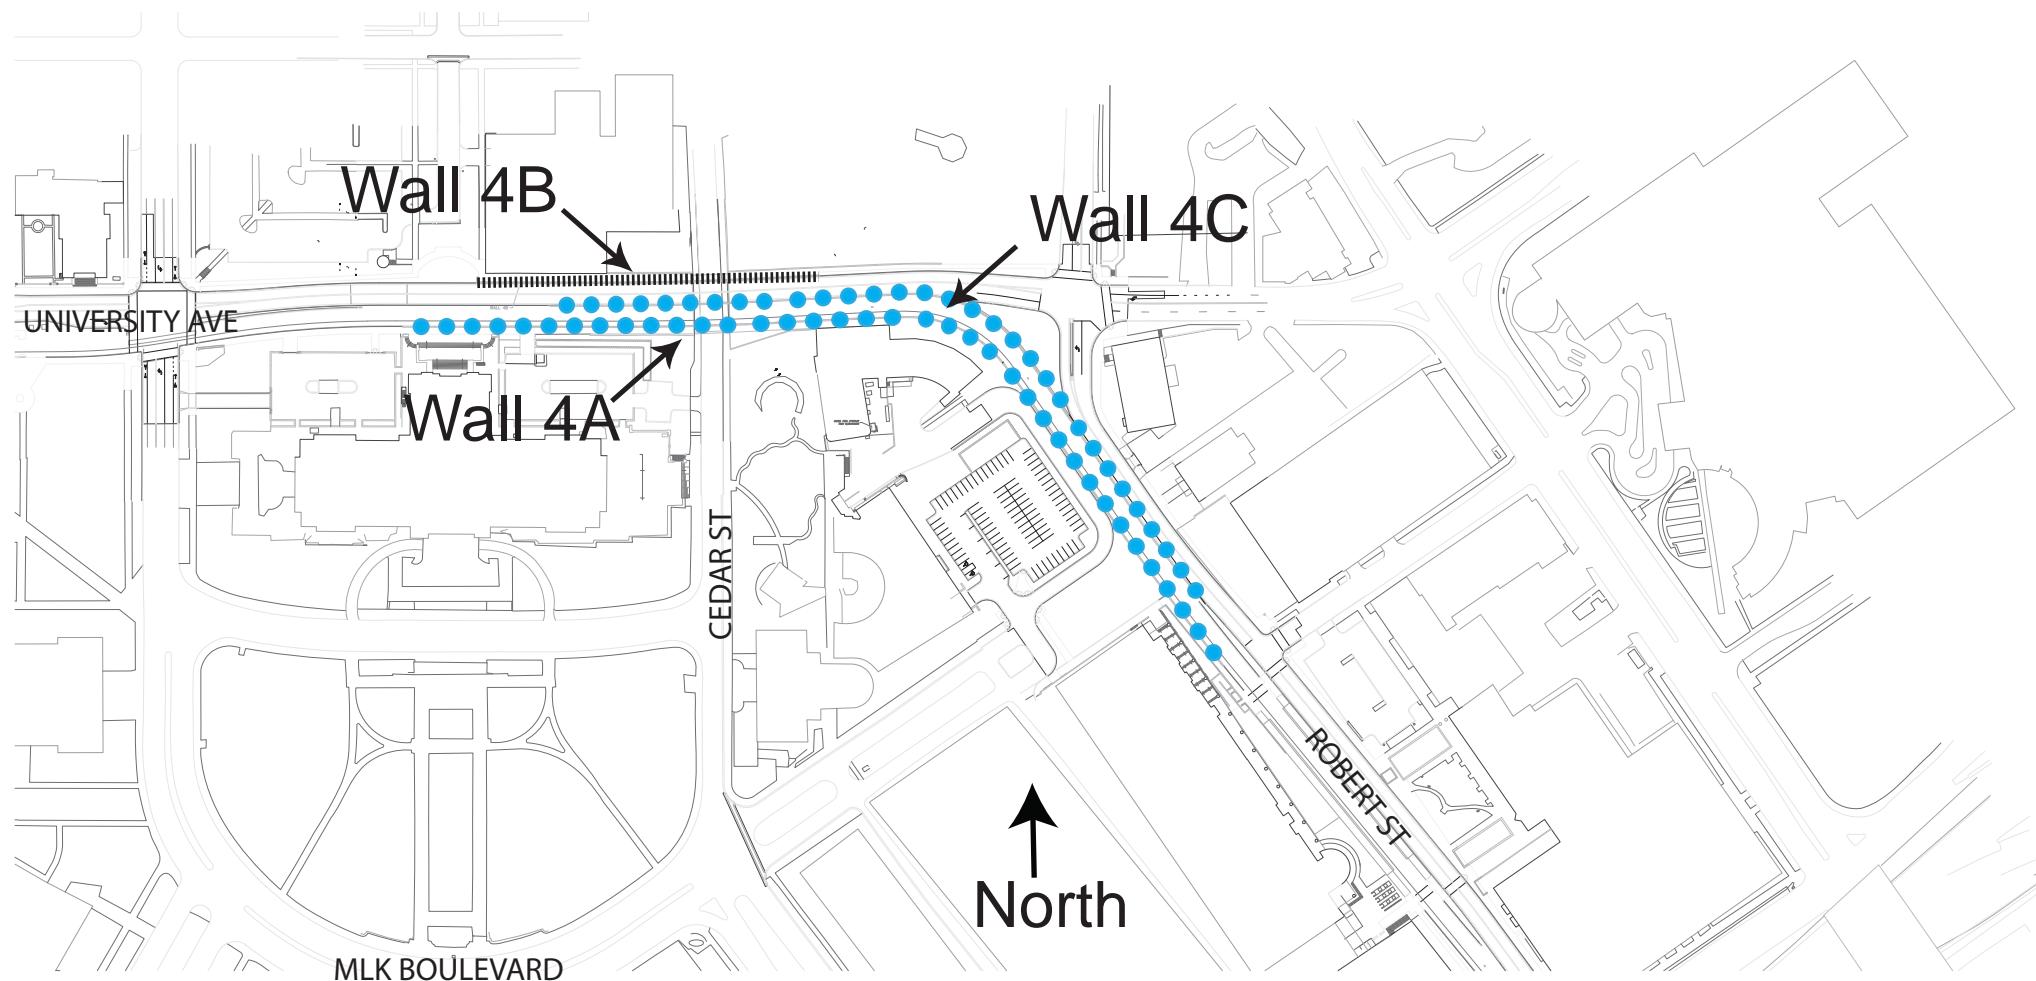


- Ramsey County
- Metropolitan Council

Retaining Walls/Fences

Exhibit F



0 10 20 40
SCALE

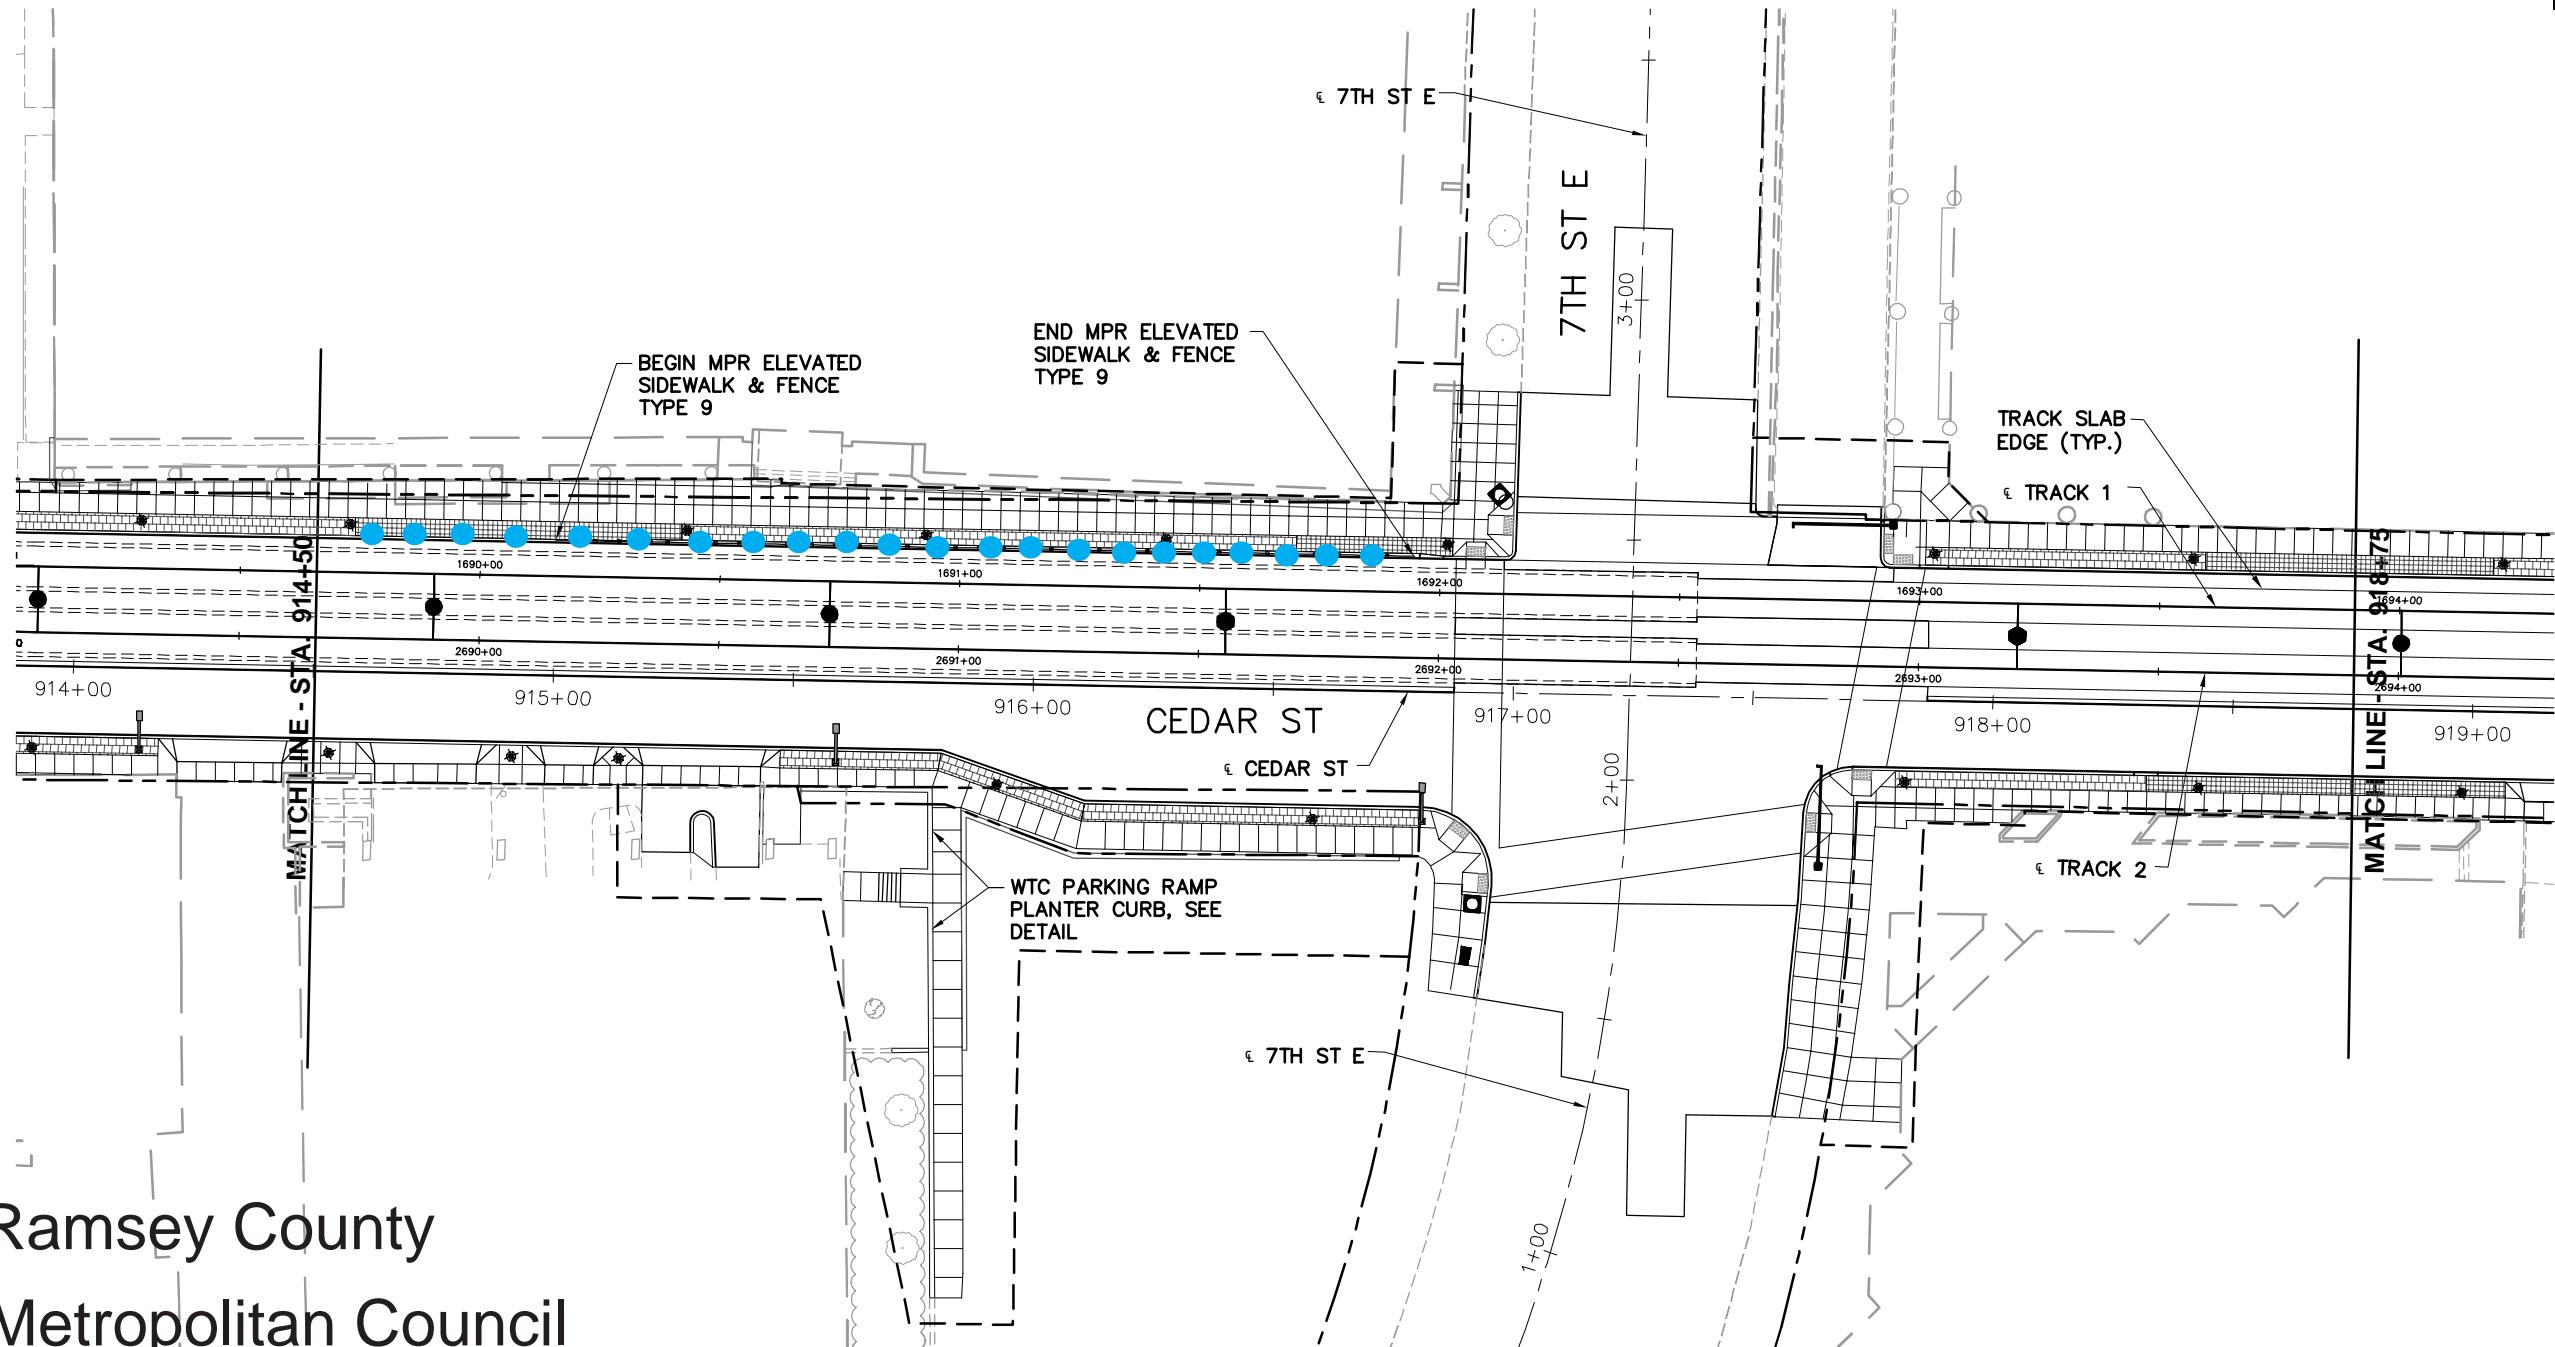


Retaining Walls/Fences

Exhibit F

NO.	DATE	BY	CHECK	DESIGN	REVISION / SUBMITTAL	THESE RECORD DOCUMENTS HAVE BEEN PREPARED BASED ON INFORMATION PROVIDED BY OTHERS TO SHOW THE REPORTED LOCATION OF THE WORK AND SIGNIFICANT CHANGES MADE DURING THE CONSTRUCTION PROCESS. BECAUSE THESE RECORD DOCUMENTS ARE BASED ON UNVERIFIED INFORMATION PROVIDED BY OTHER PARTIES, AECOM AND ITS SUBCONTRACTORS CANNOT AND DO NOT WARRANT THEIR ACCURACY OR COMPLETENESS, AND SHALL NOT BE RESPONSIBLE FOR ANY ERRORS OR OMISSIONS THAT MAY BE INCORPORATED HEREIN AS A RESULT. SIMILARLY, AECOM AND ITS SUBCONTRACTORS ARE NOT RESPONSIBLE FOR THE MEANS OR METHODS OF CONSTRUCTION OR "AS-BUILT" CONSTRUCTION THAT DIFFERS FROM SIGNED AND SEALED DESIGN DRAWINGS. THE PLACING OF ANY PROFESSIONAL SEAL AND THE SIGNATURE OF THE ENGINEER ON THESE RECORD DOCUMENTS ARE SUBJECT TO THE FOREGOING DISCLAIMER OF RESPONSIBILITY AND LIABILITY.	AECOM	Central Corridor Light Rail Transit	CIVIL EAST CONSTRUCTION - VOLUME 7	URBAN DESIGN PLAN	CEDAR ST 914+50 - 918+75	SHEET
1	07/30/2013	RBC	TPH	TPH	AS-BUILT SHEET					2711		
2	04/06/2012	ALA	TPH	TRH	ADJUSTED PAVER BAND FOR TURN LANE					OF		
3	03/31/2010	ALA	TPH	TRH	ADDENDUM NO. 2 - SIDEWALK JOINTS					4851		
0	02/24/2010	ALA	TPH	TRH	ISSUED FOR BID							



0 10 20 40
SCALE

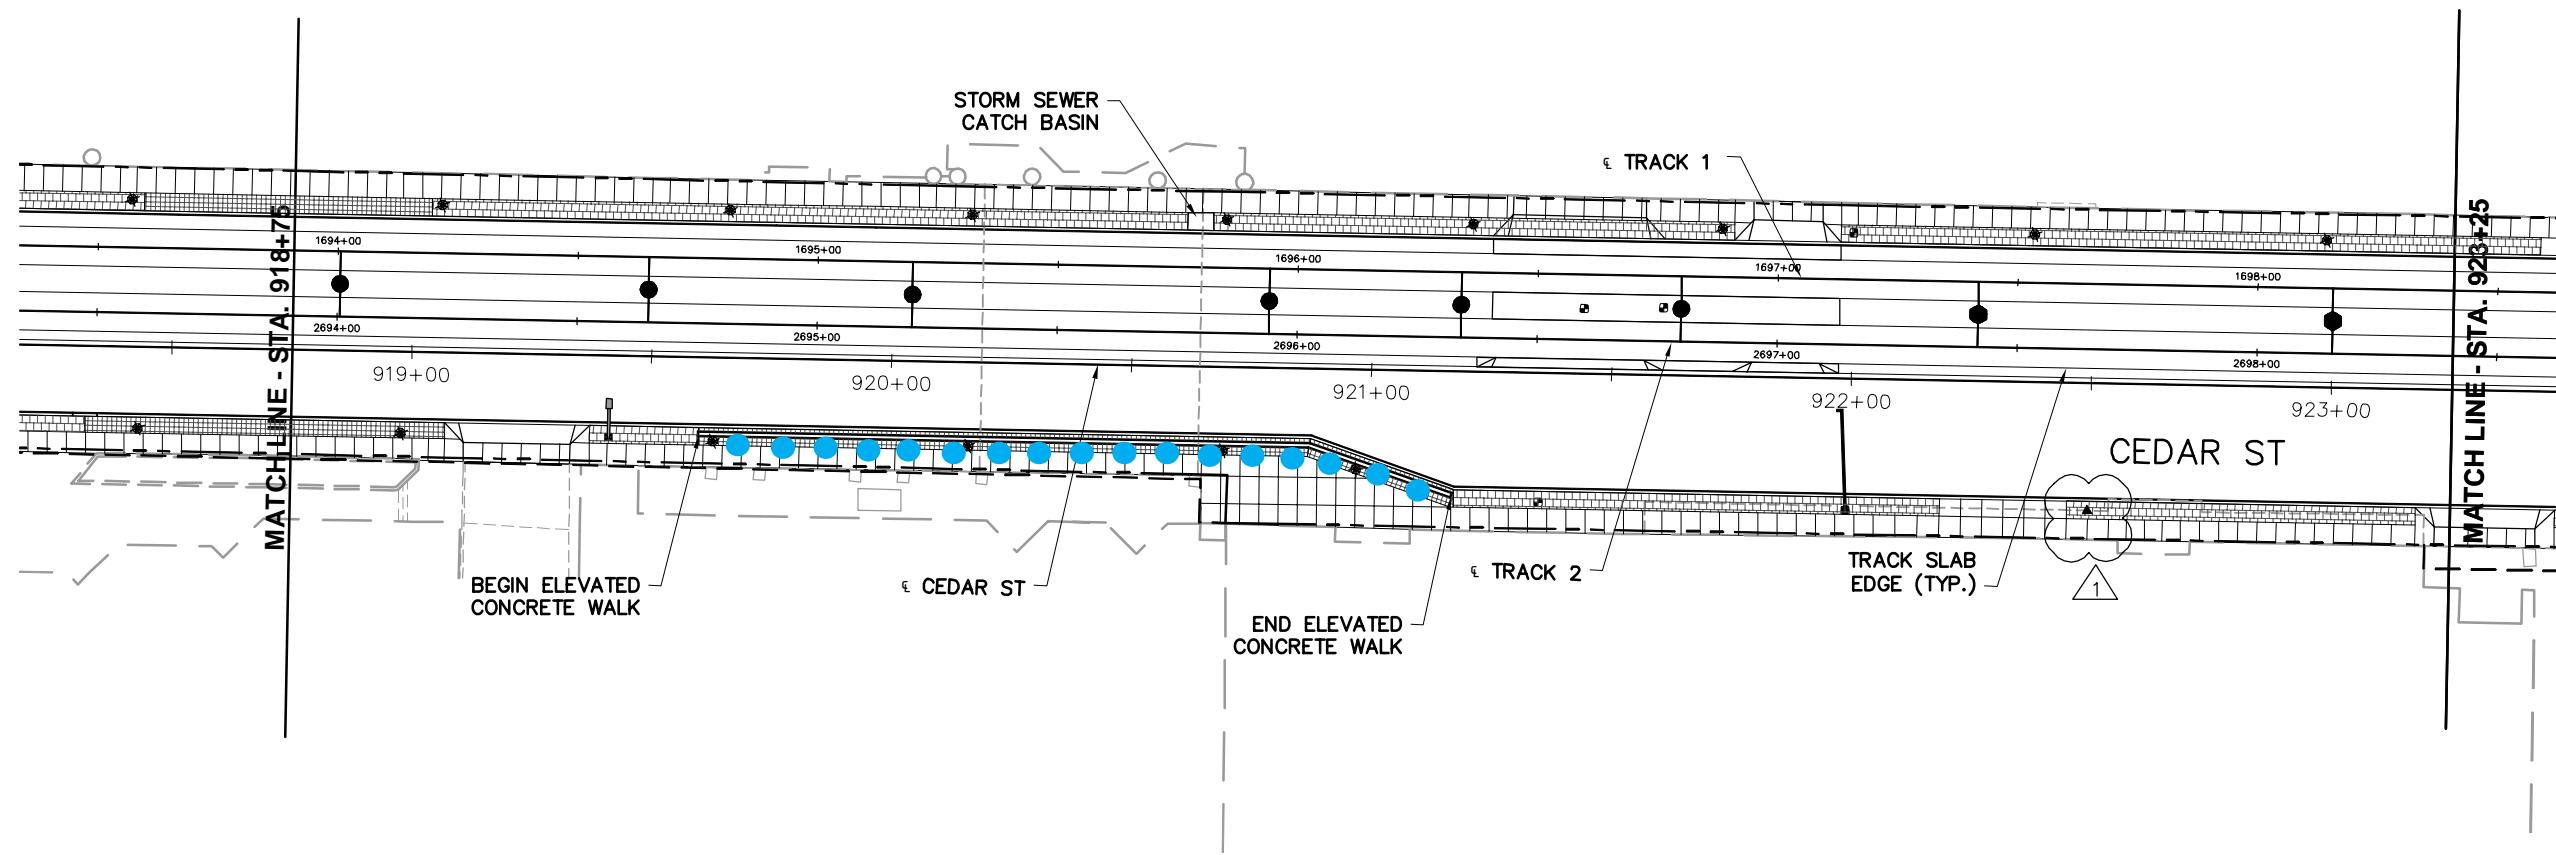

Ramsey County

• • • Metropolitan Council

Retaining Walls/Fences

Exhibit F

NO.	DATE	BY	CHECK	DESIGN	REVISION / SUBMITTAL
•	•	•	•	•	
•	•	•	•	•	
A	07/30/2013	RBC	TPH	TPH	AS-BUILT SHEET
1	03/31/2010	ALA	TPH	TRH	ADDENDUM NO. 2 - TRASH RECEPTACLE ADDED
0	02/24/2010	ALA	TPH	TRH	ISSUED FOR BID

THESE RECORD DOCUMENTS HAVE BEEN PREPARED BASED ON INFORMATION PROVIDED BY OTHERS TO SHOW THE REPORTED LOCATION OF THE WORK AND SIGNIFICANT CHANGES MADE DURING THE CONSTRUCTION PROCESS. BECAUSE THESE RECORD DOCUMENTS ARE BASED ON UNVERIFIED INFORMATION PROVIDED BY OTHER PARTIES, AECOM AND ITS SUBCONTRACTORS CANNOT AND DO NOT WARRANT THEIR ACCURACY OR COMPLETENESS, AND SHALL NOT BE RESPONSIBLE FOR ANY ERRORS OR OMISSIONS THAT MAY BE INCORPORATED HEREIN AS A RESULT. SIMILARLY, AECOM AND ITS SUBCONTRACTORS ARE NOT RESPONSIBLE FOR THE MEANS OR METHODS OF CONSTRUCTION OR "AS-BUILT" CONSTRUCTION THAT DIFFERS FROM SIGNED AND SEALED DESIGN DRAWINGS. THE PLACING OF ANY PROFESSIONAL SEAL AND THE SIGNATURE OF THE ENGINEER ON THESE RECORD DOCUMENTS ARE SUBJECT TO THE FOREGOING DISCLAIMER OF RESPONSIBILITY AND LIABILITY.



AECOM



Kimley-Horn
and Associates, Inc.



Central Corridor
Light Rail Transit

CIVIL EAST CONSTRUCTION - VOLUME 7

URBAN DESIGN PLAN

CEDAR ST 918+75 - 923+25

SHEET
2712
OF
4851
NAME: URD-E-PLN-077