



**PLAN APPROVED**  
Heritage Preservation Commission  
City of St. Paul  
File # 275  
Address 71 N. Wabasha  
Date 5.15.88  
Drawn by A.S.  
Approved by the Heritage Preservation Commission

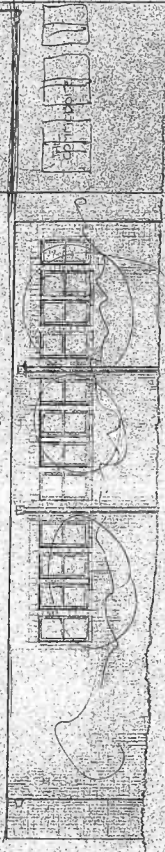

○ SOUTH ELEVATION  
SCALE 1/2" = 1'-0"

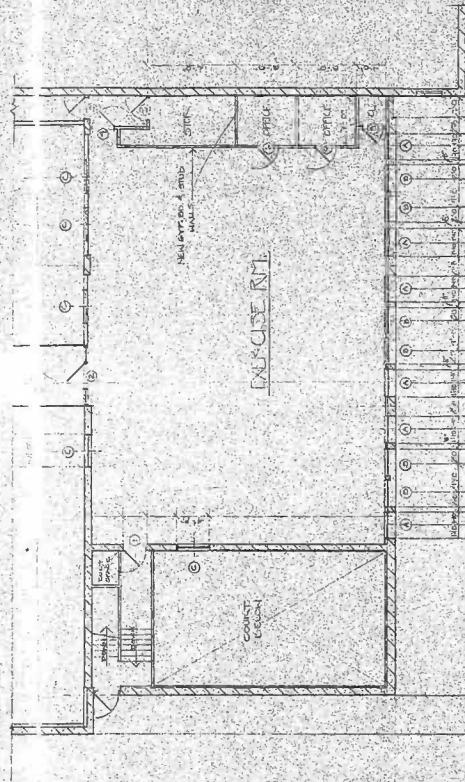


○ PLAN - SOUTH END  
SCALE 1/8" = 1'-0"

THOMAS R. BLANCIA I.A.  
ARCHITECT  
111 W. WABASHA ST.  
ST. PAUL, MN 55102  
COLUMBIAN SQUARE PLAZA  
CLUB - RECREATION ROOM  
PLAN & ELEVATION  
SHEET NO. 5/10  
DATE 5/15/88  
DRAWN BY A.S.  
CHECKED BY T.R.B.  
APPROVED BY T.R.B.


Combined  
Pg 215

**EXHIBIT**  
**57-1**  
tabbles®

**SOUTH ELEVATION**  
SCALE 1/8" = 1'-0"

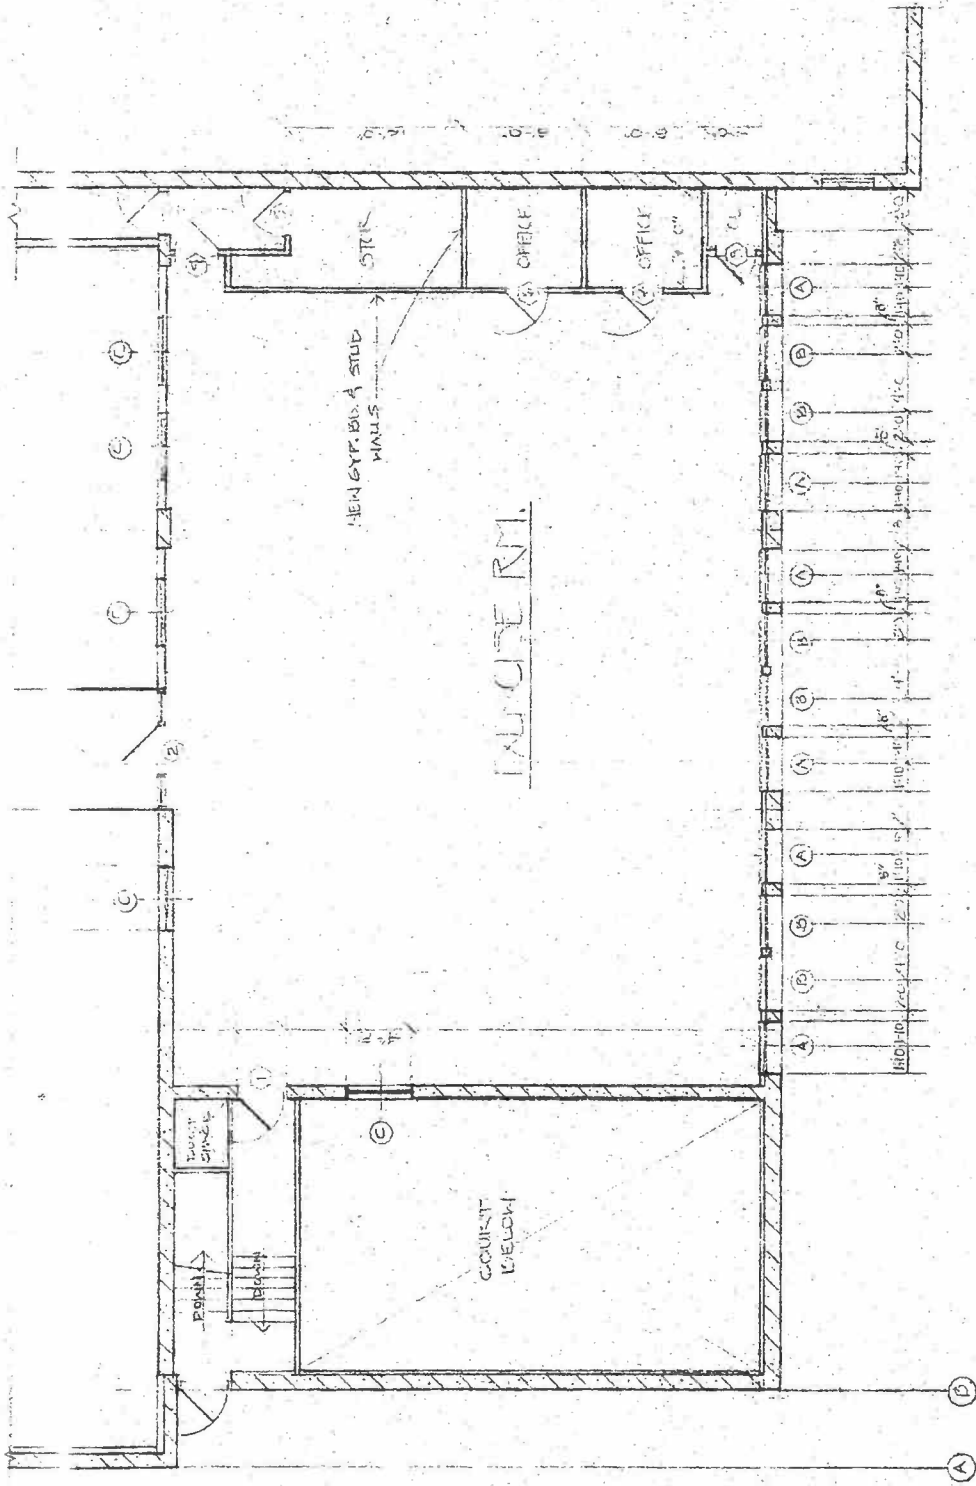

PLAN - SOUTH END  
SCALE 1/8" = 1'-0"

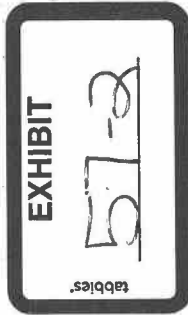

<b>THOMAS R. BLANK A.I.A.</b> ARCHITECT 79 WEST 11th ST. ST. LOUIS, MO. 63103	
COMMODORE SQUASH RACKETS CLUB - EXERCISE ROOM.	PROJECT NO. 5722
PLAN & ELEVATION	SHEET NO. A1
DRAWN BY: _____ CHECKED BY: _____ DATE: _____	SCALE: _____

Combined  
page 215

**GENERAL BUILDING PERMIT**  
CITY OF SAINT PAUL

INSPECTOR  
LOADING INSPECTION & DESIGN DIVISION  
W. KELLOGG BLVD.  
445 CITY HALL  
ST. PAUL, MN 55102

043353

Permit No.

(WINDOWS)

REMODEL

PLAN NO. 1-172

DATE 7-22-87 OWNER T.R. O'Brien

OWNERS ADDRESS 79 Western Ave.

OLD TYPE OF OCCUPANCY B-2  
 NEW TYPE CONST.

BUILD  GRADING AND EXC.  STUCCO OR PLASTER  DRYWALL  FENCE

ADDITION  ALTER  REPAIR  MOVE  WRECK

NUMBER	STREET	SIDE	CROSS STREETS
79	N. Western		

WARD	LOT	BLOCK	ADDITION OR TRACT

LOT	WIDTH	DEPTH	SIDE LOT CLEARANCE		BUILDING LINE	
			FRONT	REAR		

STRUC-TURE	WIDTH	LENGTH	HEIGHT	STORIES

ESTIMATED VALUE	BASEMENT	TOTAL FLOOR AREA
15,000	<input type="checkbox"/> YES <input type="checkbox"/> NO	SQ. FT.
		INCLUDE BASEMENT

DETAILS & REMARKS:

Subj. to HPC Appr.

HPC APPROVED / RES 786 / 8.13.87 / ACT

ARCHITECT Tom Blouck TEL. NO. 92-1534

CONTRACTOR [Signature] 21-9133


MASONRY

PERMIT FEE	162.00	STATE VALUATION	15,000
(A.P.C. PLAN CHECK)	105.30	09/24/87 0009610:14AM CLERK 1 2811 BUILDING *162.00 4074 PLAN CHECK *105.30 9534 SURCHARGE B *7.50 SUBTTL *274.80 CHECK TND *274.80 CHANGE *.00	
STATE SURCHARGE	7.50	CASHIER USE ONLY	
TOTAL FEE	274.80	WHEN VALIDATED THIS IS YOUR PERMIT	

APPLICANT CERTIFIES THAT ALL INFORMATION IS CORRECT AND THAT ALL PERTINENT STATE REGULATIONS AND CITY ORDINANCES WILL BE COMPLIED WITH IN PERFORMING THE WORK FOR WHICH THIS PERMIT IS ISSUED.

\* [Signature]  
AUTHORIZED SIGNATURE

St. Code \_\_\_\_\_  
ADDRESS OF JOB 79 N. WESTERN

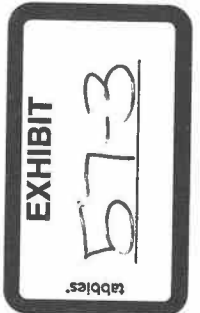

# INSPECTION REPORT

Inspector \_\_\_\_\_

Foundation \_\_\_\_\_

Frame \_\_\_\_\_

Lath and/or Wallboard \_\_\_\_\_

Final

10/18/88 J\*

Notes:

2 br wall  
9/25/87 w/o plane w/carp will call  
11/23/87 S/W Carl Handrails, guardsails not  
complete He will call  
1/4/88 Windows (HPC) OK

