


M-1

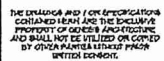

GENESIS
MANAGEMENT SYSTEMS
 4120 Baker Road, Suite 400 Phone: 952.897.787
 Minneapolis, MN 55411 Fax: 952.897.7740

PROJECT:
HMONG VILLAGE


1001 JOHNSON PARKWAY
ST. PAUL, MN

AS-BUILT PLAN/
MARKETING

JOB
DRAWN BY: AM
CHECKED BY: DCS
SHEET NO:

$53 \times 12 = 636$

53'

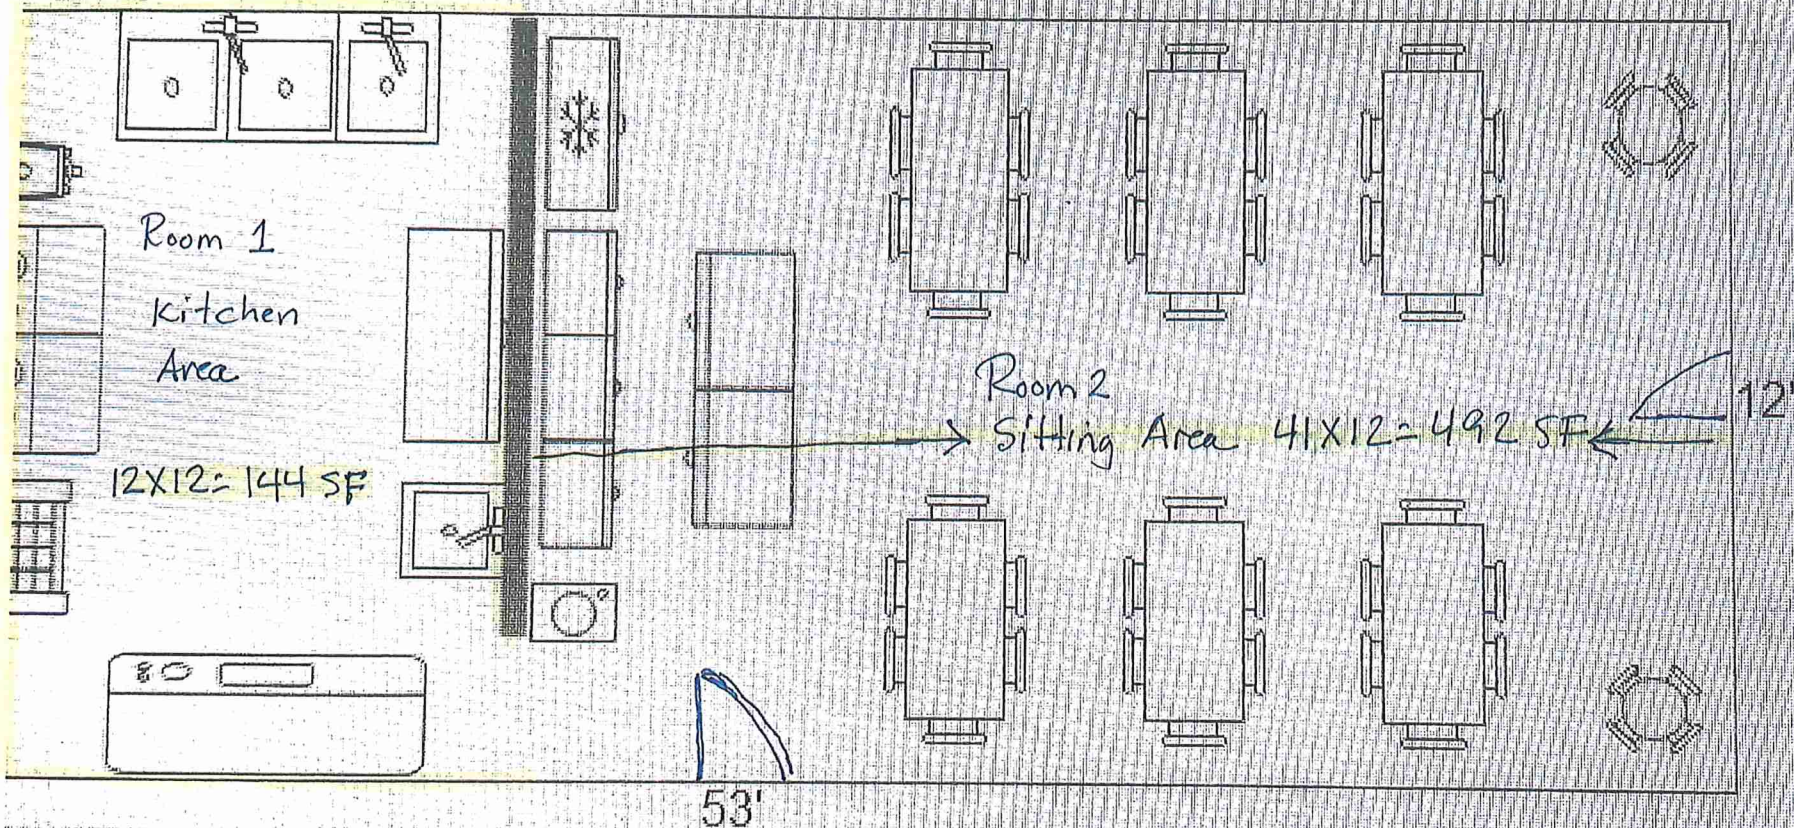

ER KAFE