

Date of Determination: 12/06/21

Determination Expiration: 12/06/23

Greetings!

Please see the determination below.

Project Name: Spot Bar
Project Address: 859 Randolph Avenue
Suite #/Campus: N/A
City Name: St. Paul
Applicant: Bruce Pastorius, Collective Carpentry

Special Notes: The project is required to be reported **with your normal SAC Activity Report** if a permit is issued.

Charge Calculation:

Food & Drink: 1216 sq. ft. @ 300 sq. ft. / SAC = 4.05
Food & Drink - Outdoor Seating: 475 sq. ft. @ 1200 sq. ft. / SAC = 0.40

Total Charge: 4.45

Credit Calculation:

Food & Drink (Grandparent 1998 City Permit): 1216 sq. ft. @ 300 sq. ft. /SAC = 4.05

Total Credit: 4.05

Net SAC: 0.40 = **0 SAC Due**

The business information was provided to MCES by the applicant at this time. It is the City's responsibility to substantiate the business use and size at the time of the final inspection. If there is a change in use or size, a redetermination will need to be made. If you have any questions email me at: toni.janzig@metc.state.mn.us.


Thank you,

Toni Janzig

SAC Technician

Please visit our SAC website by going to: <http://www.metrocouncil.org/SACprogram>

CHANGED TO 20x20 DECK WHICH IS SMALLER THAN ORIGINAL DECK PLAN, OK FOR PLAN REVIEW, STILL NO SAC OWED.

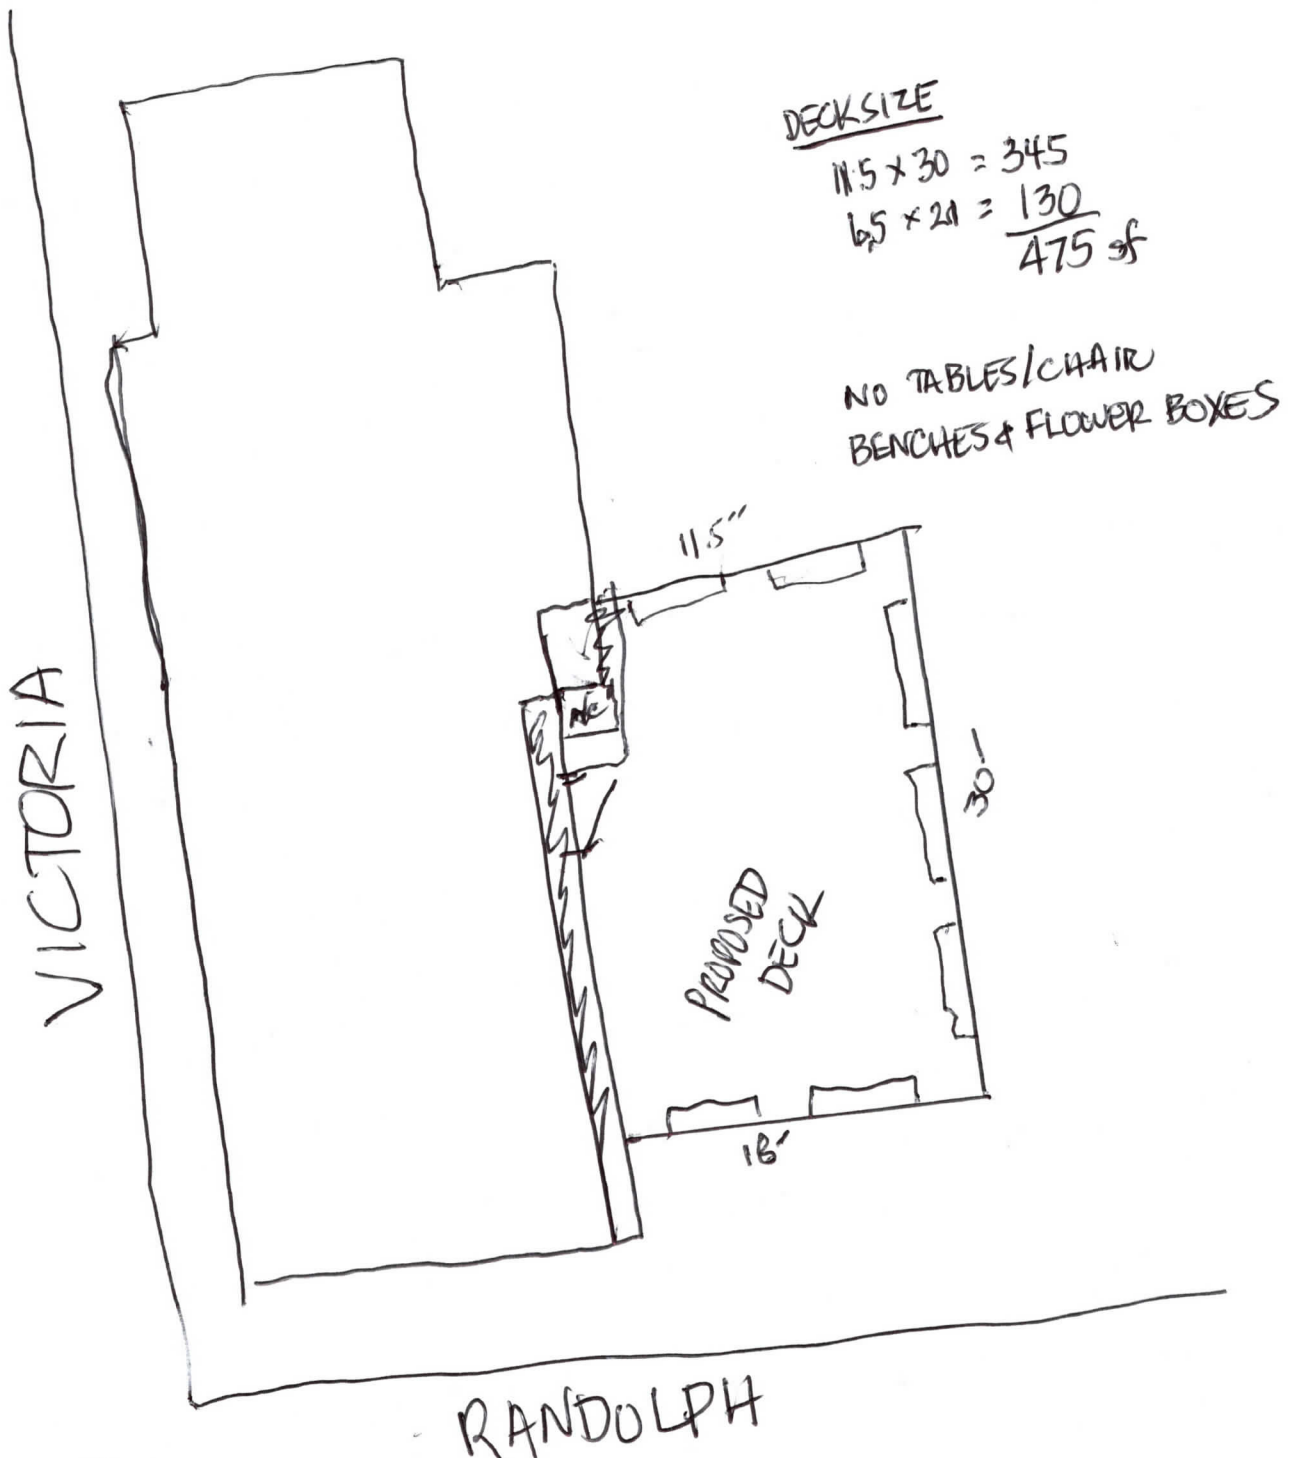


DECK SIZE
 $11.5 \times 30 = 345$
 $6.5 \times 21 = 130$
475 sf

SPOT BAR
DECK
SIZE

15 x 16 = 240
 20 x 48 = 960
 18 x 11 = 16.50
 Total: 1216.50

VICTORIA

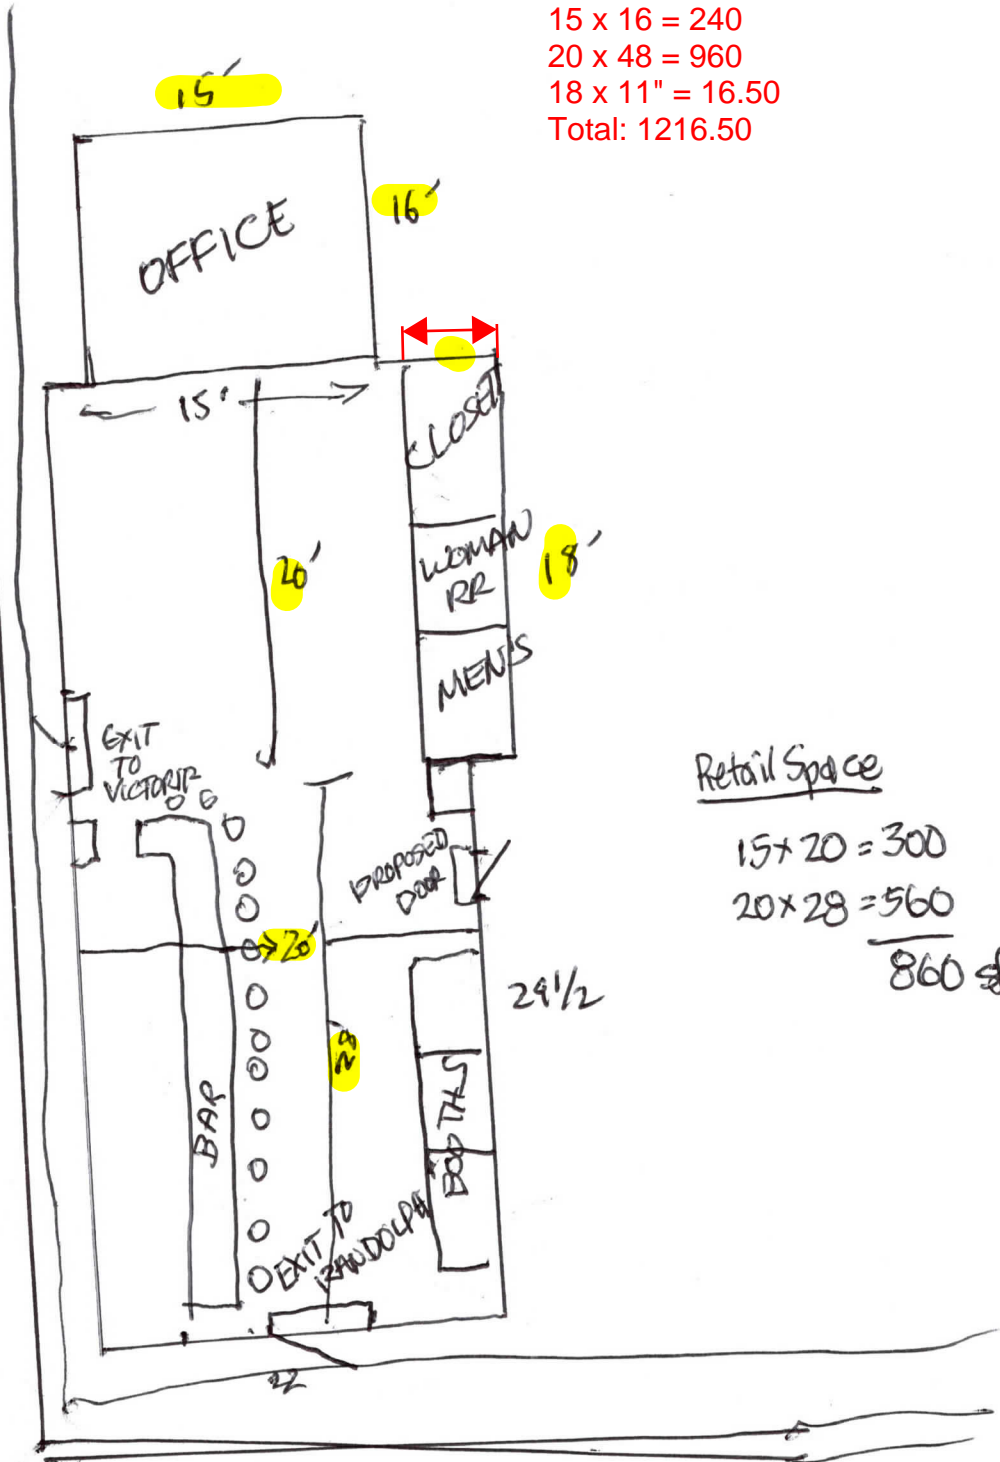


Retail Space

15 x 20 = 300
 20 x 28 = 560
860 sf


RANDOLPH

SPOT BAR INTERIOR

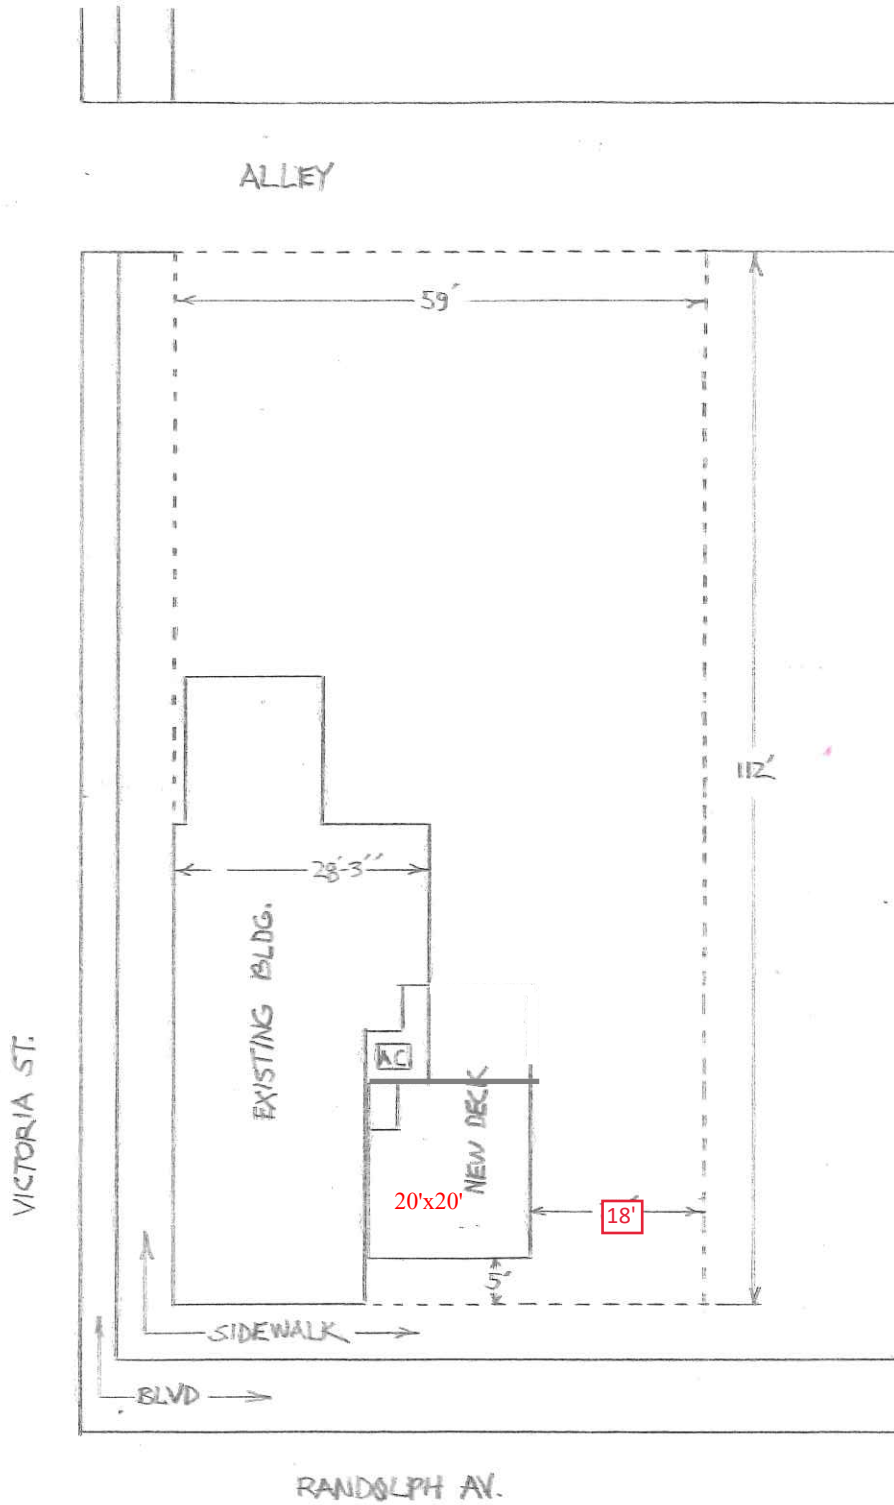

SPOT BAR 8,59 RANDOLPH AVE ST, PAUL MN 55102 MERIDITH OTOOLE	SITE PLAN SCALE: 3/4" = 1'-0"
---	----------------------------------




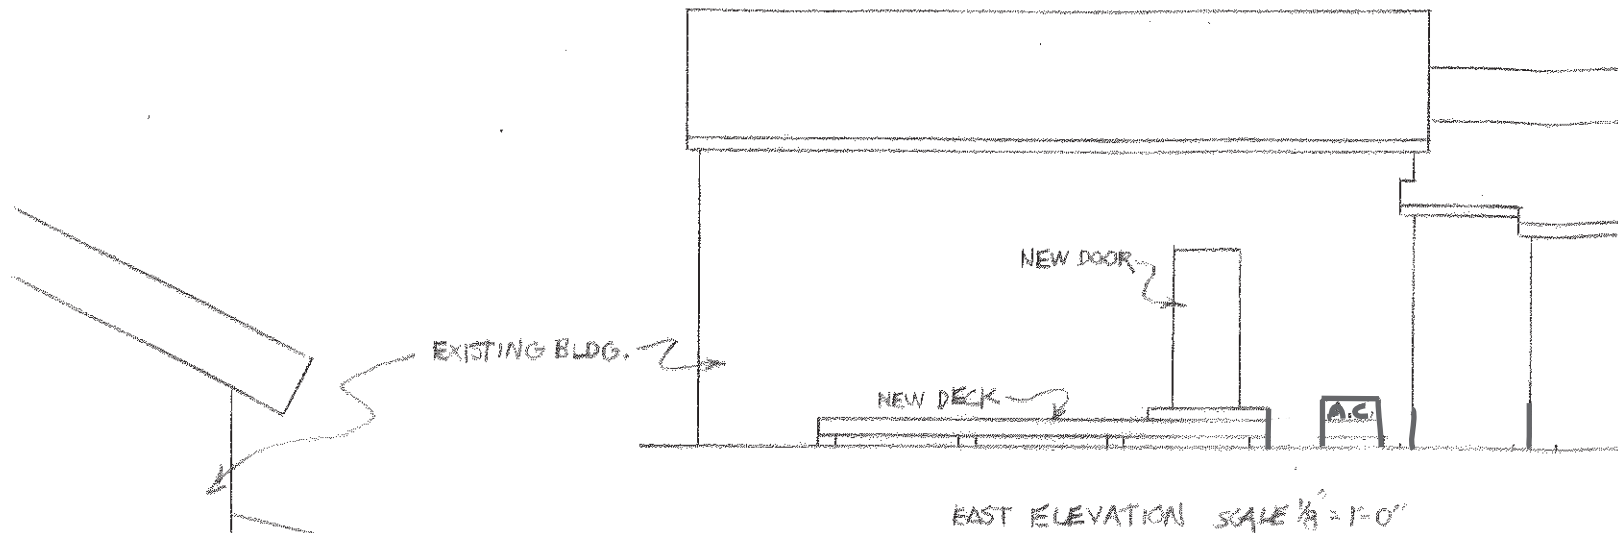

Reviewed plans must remain on job site until final inspection approval.

Separate permits required for all trade work. Plumbing, Mechanical, Electrical, Warm Air...etc.

MN ACCESSIBILITY CODE COMPLIANCE REQUIRED. INSTALL EXACTLY PER CODE. ALL ERRORS MUST BE CORRECTED.

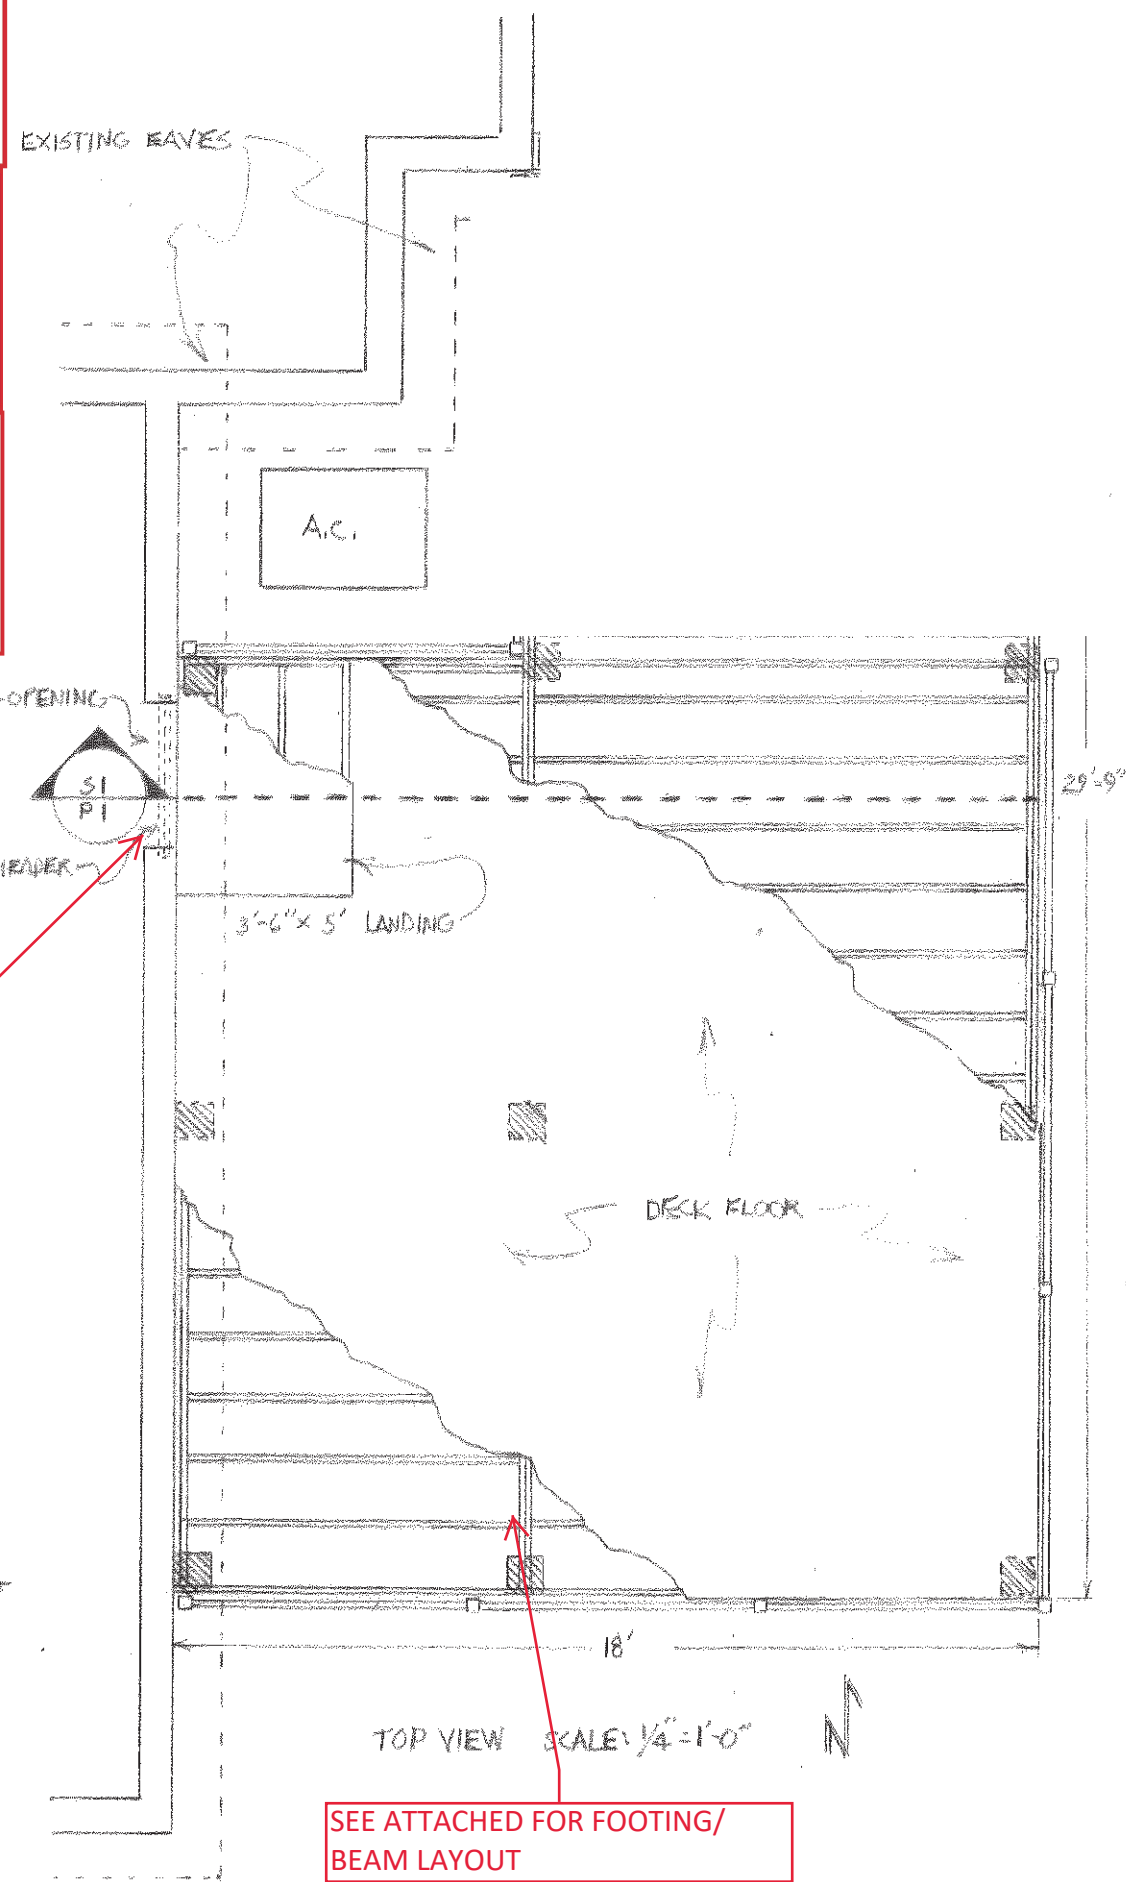

NO LANDING HERE DECK TO BE BOUT 22" OFF THE GROUND AND NO MORE THAN 3/4" BELOW THE INTERIOR FLOOR SURFACE FOR ACCESSIBILITY.

SEE ATTACHED SEATING PLAN, OCCUPANT LOAD OF 20X20 DECK WITH TABLES/CHAIRS IS LESS THAN 50' DOOR SWING CAN GO EITHER WAY.

SEE ATTACHED FOR FOOTING/ BEAM LAYOUT

SPOT BAR 859 RANDOLPH AVE SP. PAUL MN 55102 MERIDITH JOOLE	OUTDOOR LOUNGE 8'x19' DECK 10'x30' DECK 37 LF PRIVACY FENCE P.I
---	---

ALTERNATE ACCEPTABLE FOOTING LAYOUT: FOR A DECK USING 8"x8" PRECAST FOOTINGS, TRIBUTARY AREA FOR EACH FOOTING WOULD BE A MAXIMUM OF 9 SQUARE FEET (FOOTINGS WOULD NEED TO BE IN PLACE EVERY 3' FEET IN A GRID PATTERN MINIMUM OR EQUIVELANT).

SECTION SI PI SCALE: 1/2" = 1'-0"

5/4" x 6" TREX FLOORING
2"x8"x10' TREATED JOISTS 16" O.C. W/ DIST HANGERS
2-2"x8" TREATED BEAMS
4"x4" TREATED SUPPORT POSTS
4'x8'x8" CONCRETE PADS 9'-6" O.C.

5 GRADE
2"x8"x7 TREATED JOISTS 16" O.C.

6' PRIVACY FENCE


NEW 6'-8"x3'-0" DOOR+OPENING

2-2"x6" DOOR HEADER

3'-6"x5' LANDING

DECK FLOOR


TOP VIEW SCALE: 1/4" = 1'-0"

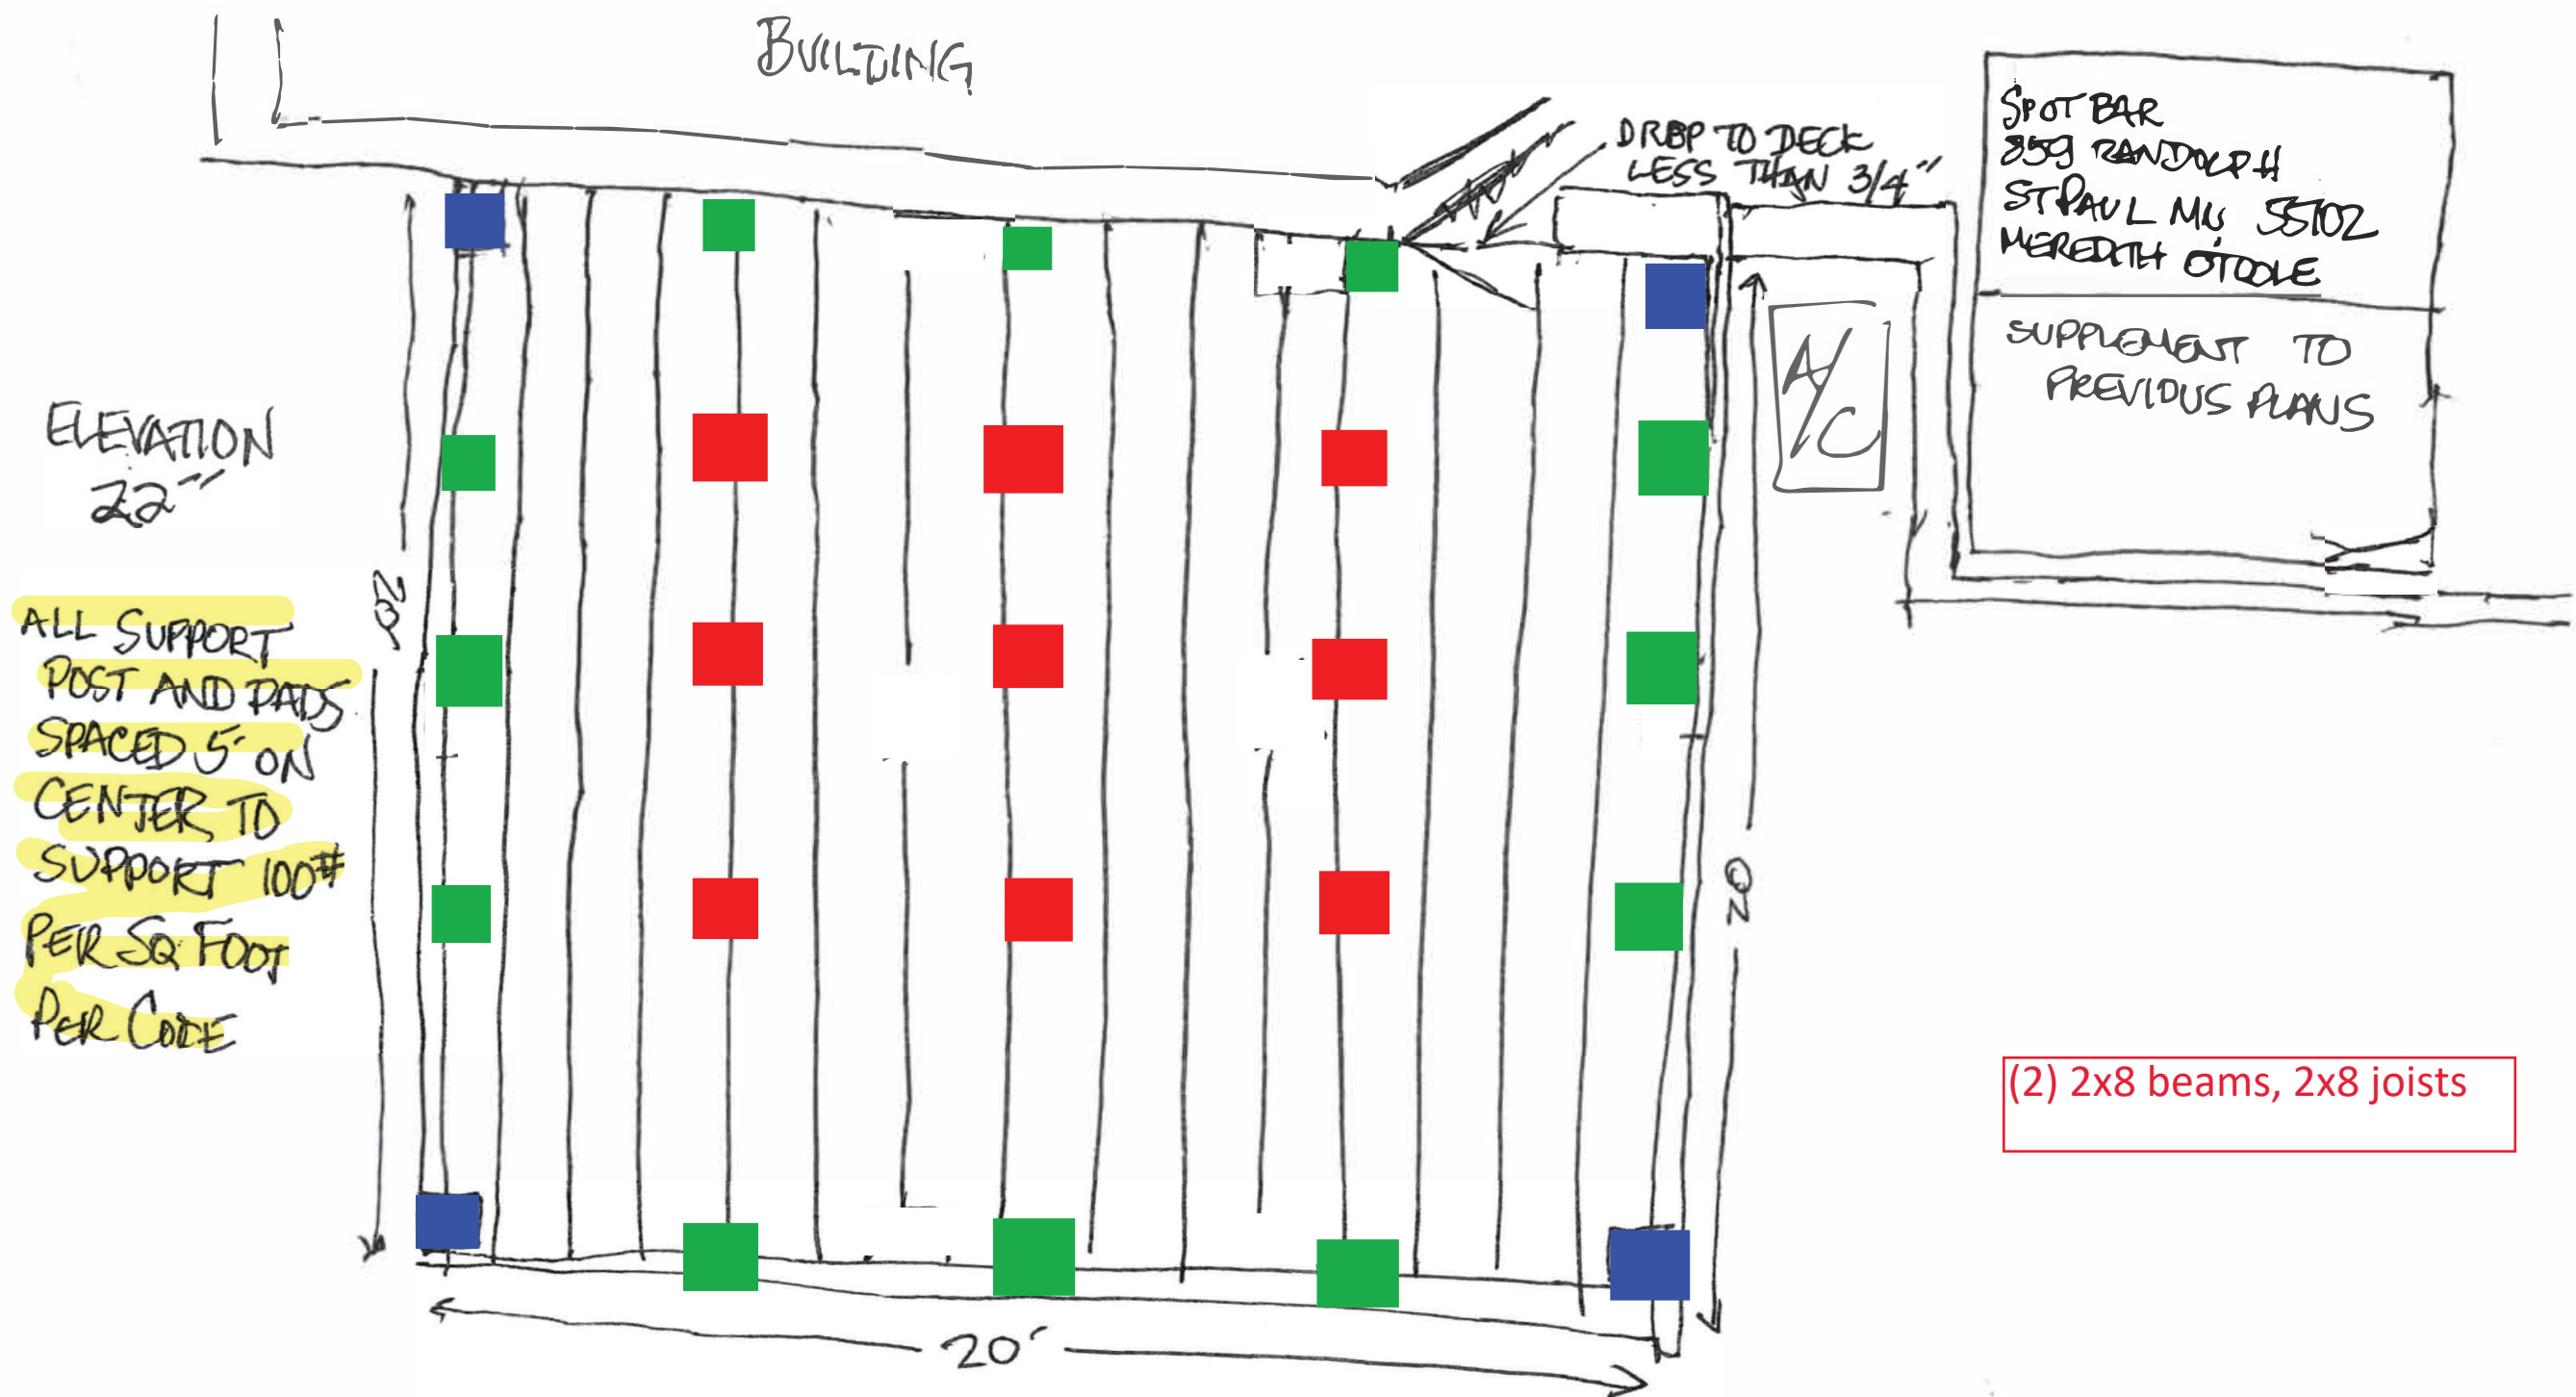

(2) 2x8 beams, 2x8 joists

- = RED FOOTINGS; SUPPORTING 2500 LBS, SIZE 14"X 14" PAD FOOTING MINIMUM
- = BLUE CORNER FOOTINGS, SUPPORTING 625 LBS, 8" X 8" PAD FOOTING MINIMUM
- = GREEN OUTER FOOTINGS, SUPPORTING 1250 LBS, 11"X 11" PAD FOOTING MINIMUM

FENCE / RAILING TO ENCLOSE ENTIRE DECK AND BE ATTACHED TO DECK

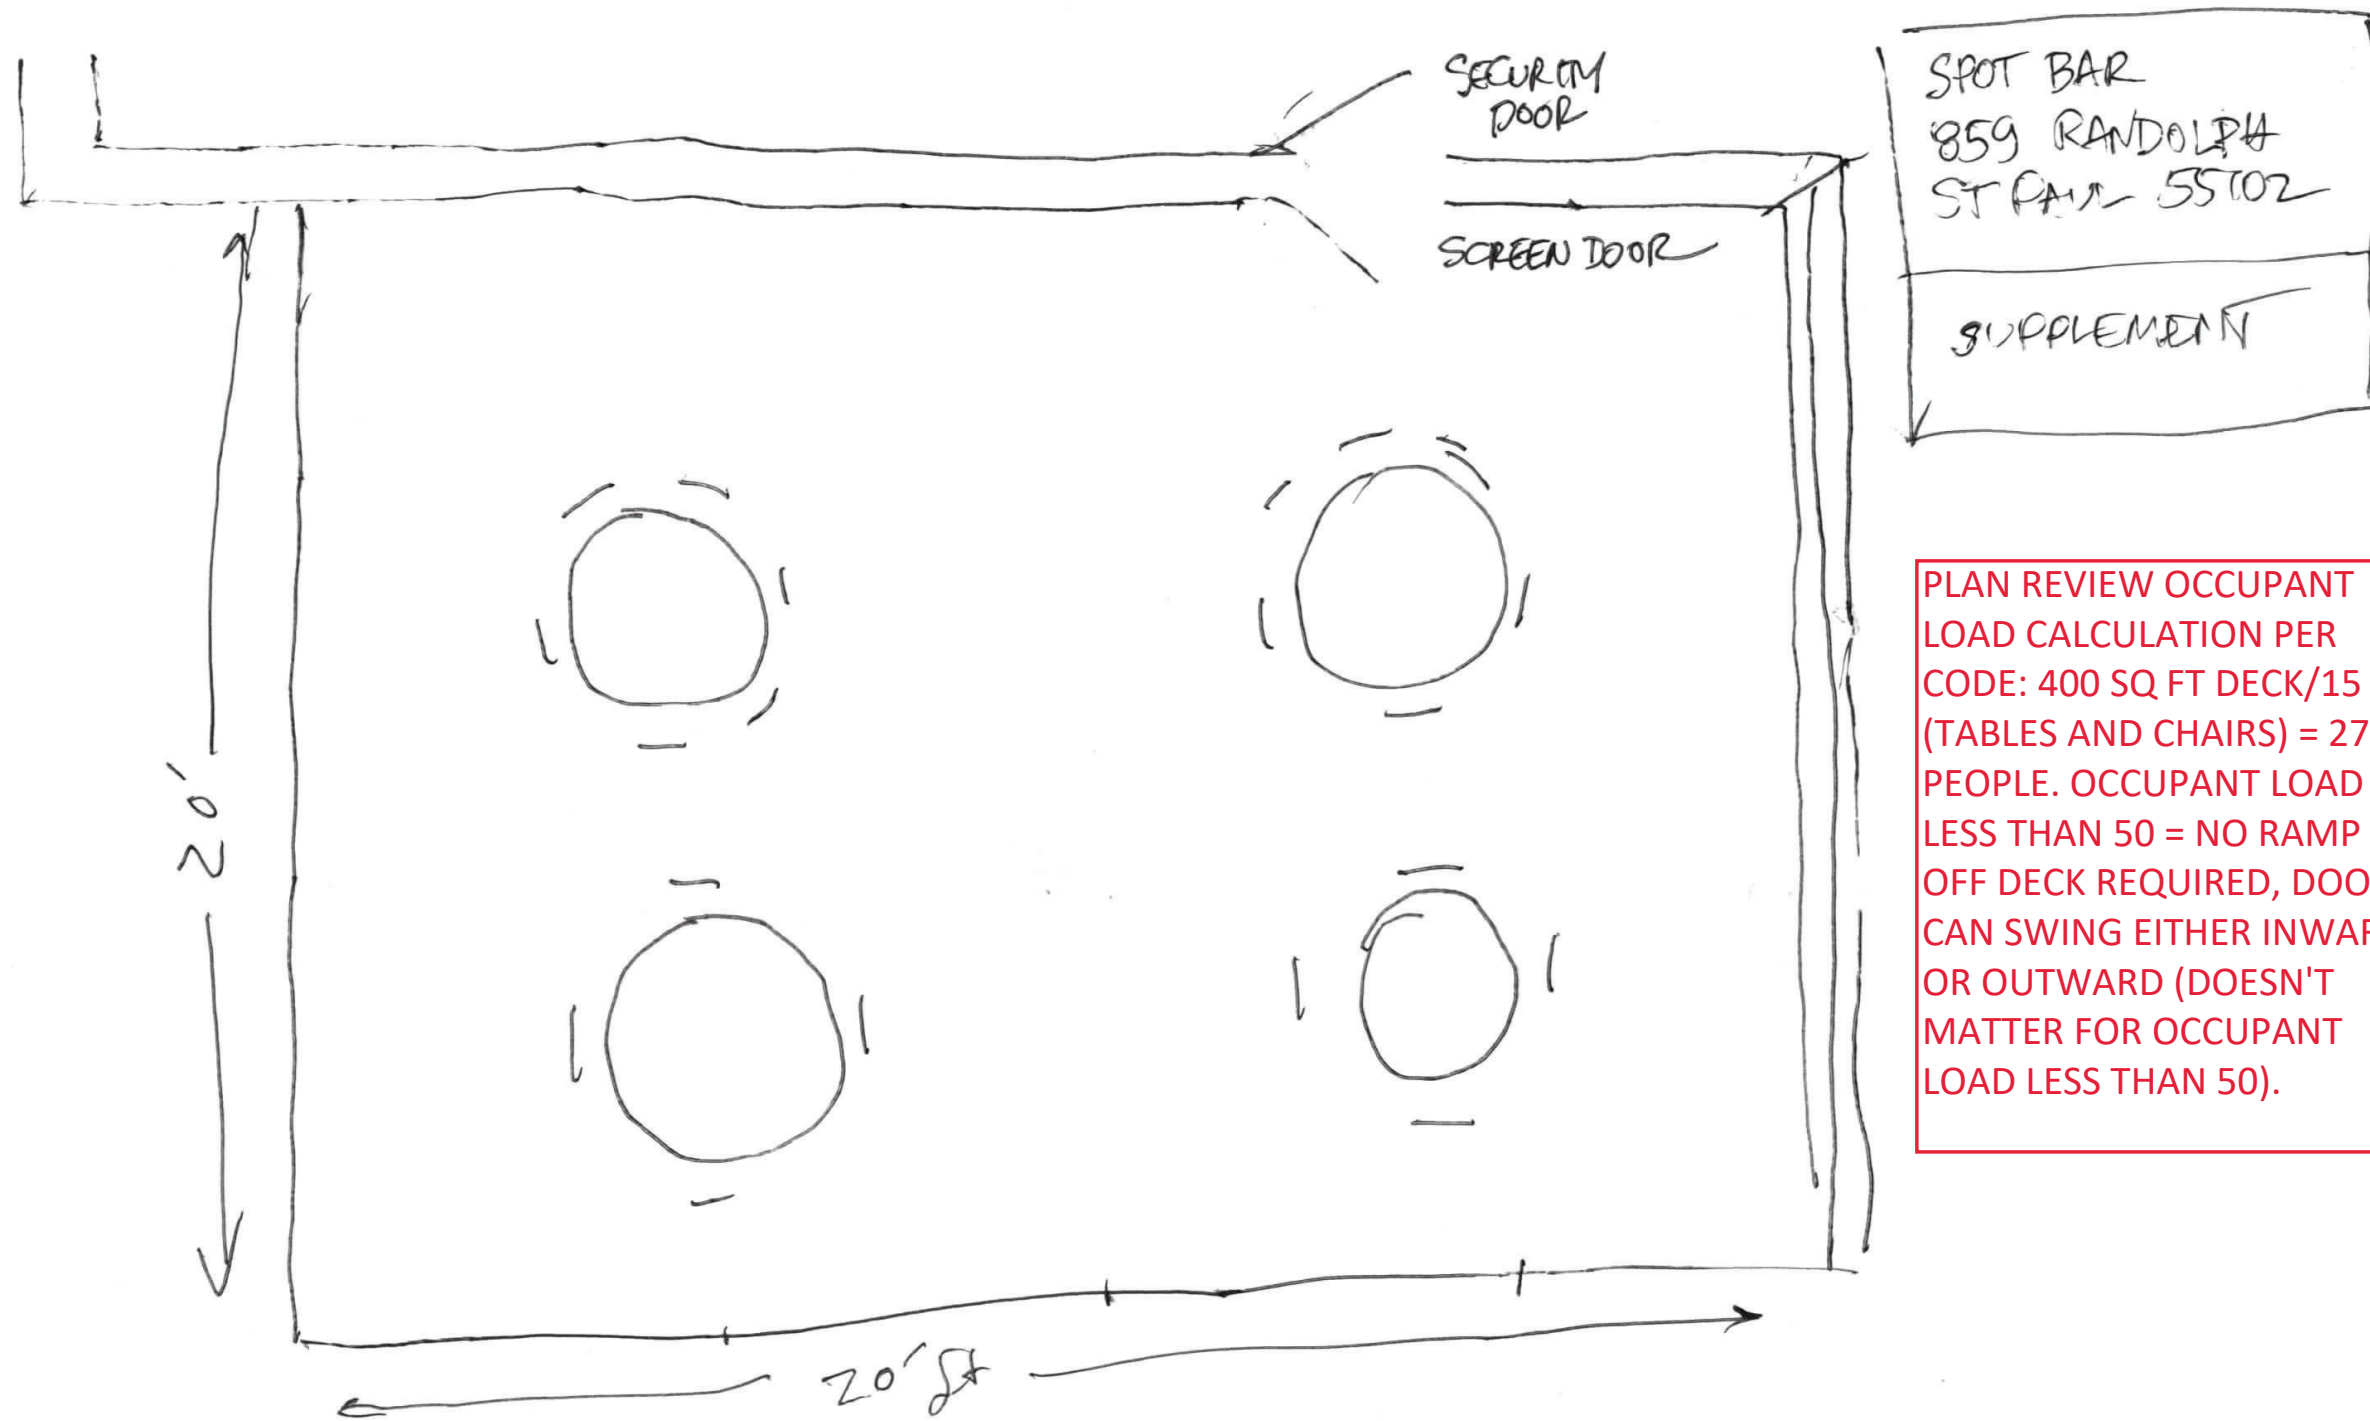

TABLES TO SEAT 4-6, MAKING SEATING 16-24, MAY BE MISCELLANEOUS
SMOKERS, BUT WOULD HARDLY SEE 36-40 PEOPLE

859 RANDOLPH AVE

CITY OF ST. PAUL
REVIEWED FOR CODE COMPLIANCE
ARCHITECTURAL V-21-2094
DATE 12/13/2021 MD
STRUCTURAL _____
DATE _____

#21-326777

REVISED PLAN 12/20/2021:
REDUCED SIZE OF PROPOSED
DECK TO 20' x 20'