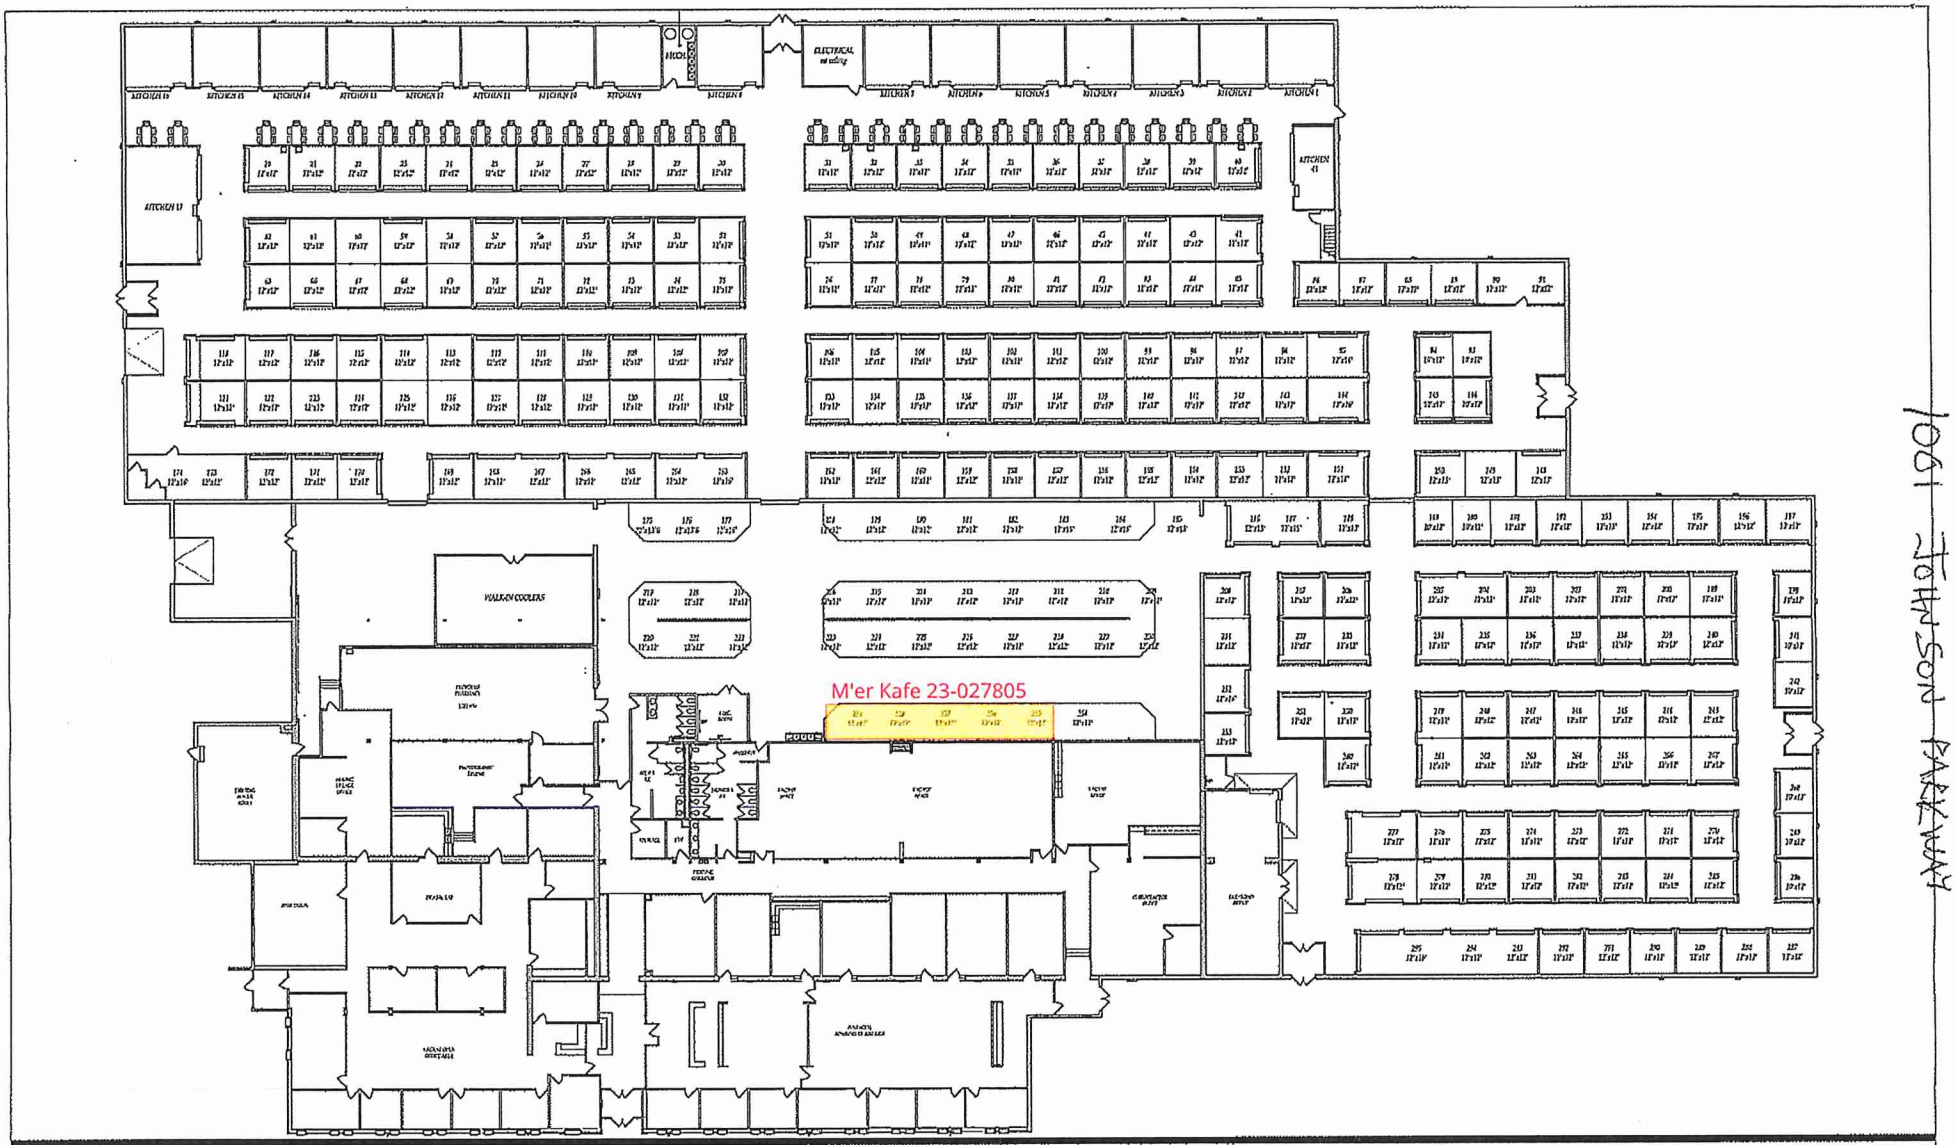

1061 JOHNSON PARKWAY

THE DRAWINGS AND / OR SPECIFICATIONS CONTAINED HERIN ARE THE EXCLUSIVE PROPERTY OF GENESIS ARCHITECTURE AND SHALL NOT BE UTILIZED OR COPIED BY OTHER PARTIES WITHOUT PRIOR WRITTEN CONSENT.

REVISION NUMBER	DATE
ISSUE FOR AS-BUILT	05-23-2

REVISION NUMBER	DATE

GENESIS
4330 Baker Road, Suite 400 Phone: 952.897.7874
Minnetonka, MN 55343 Fax: 952.897.7760

PROJECT:
HMONG VILLAGE

1001 JOHNSON PARKWAY
ST. PAUL, MN

SHEET TITLE:
AS-BUILT PLAN / MARKETING

JOB:
DRAWN BY: AJV
CHECKED BY: DGS

SHEET NO.:
M-1

53 x
12= 636

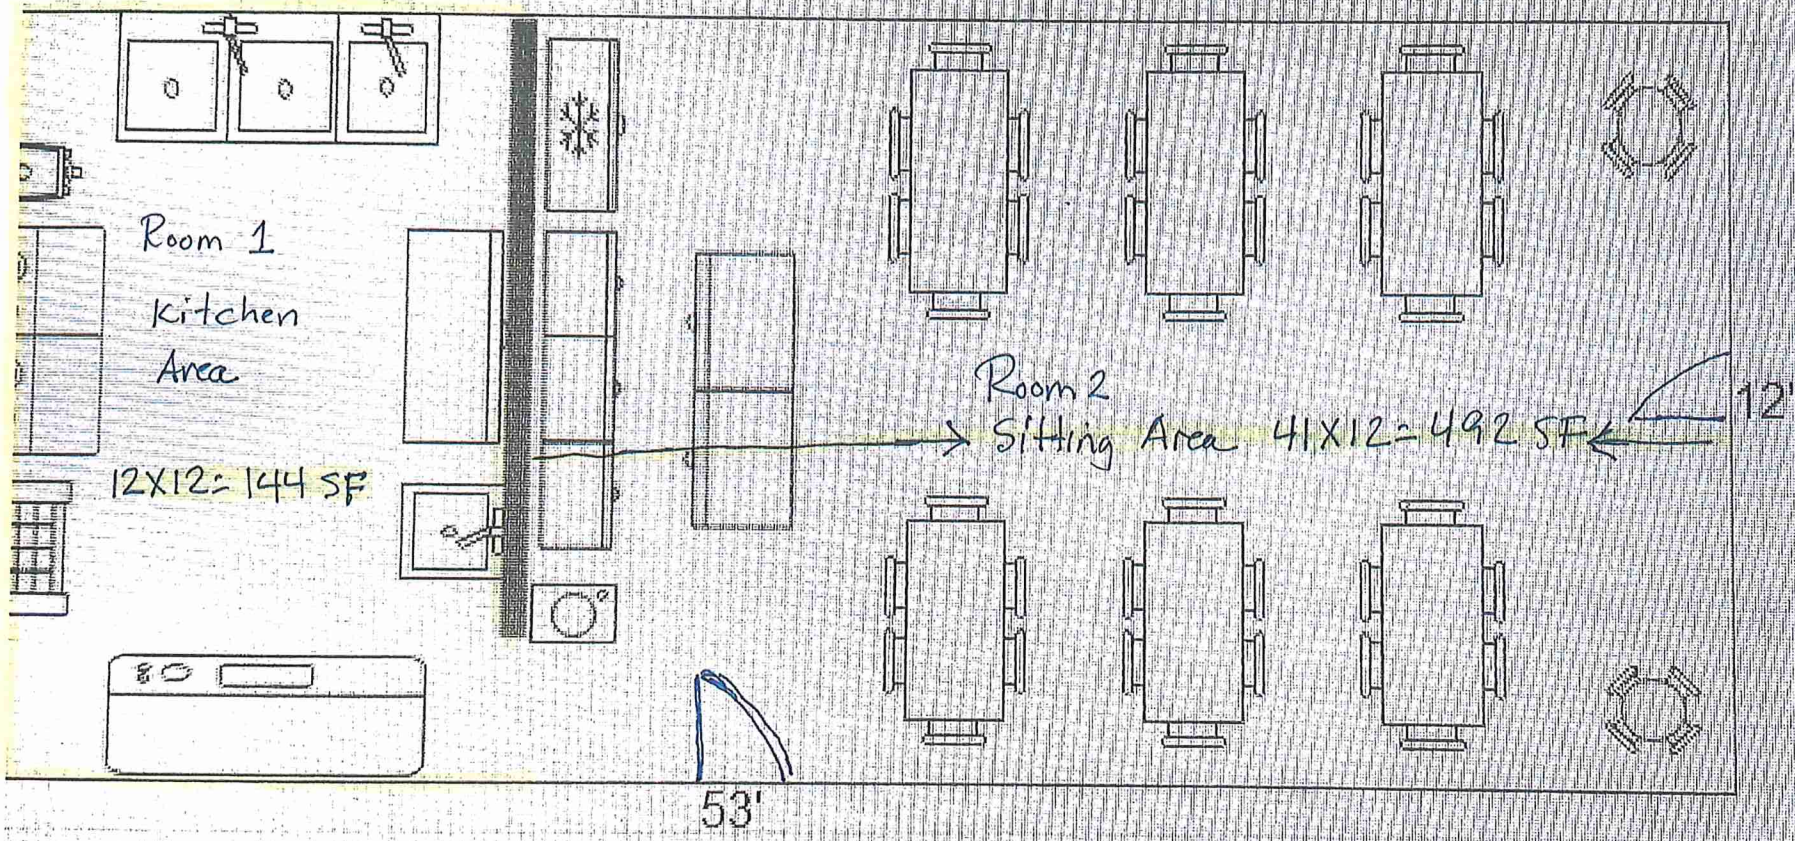

'ER KAFE